



# EAST LONGMEADOW DEPARTMENT OF PUBLIC WORKS

Job: Sewer Tie

Sheet No: \_\_\_\_\_


of \_\_\_\_\_

Calculated By: Josh C.

Date 5-4-2020

Scale: 64 Maple St (TRAIN DEPOT)

Maple St

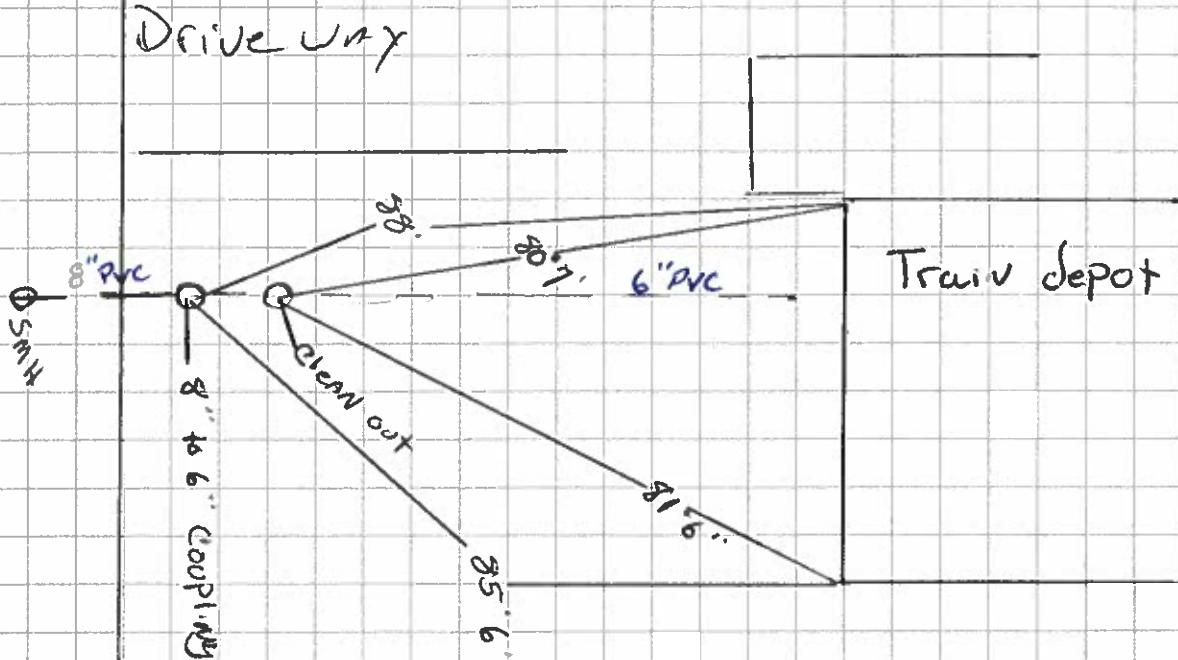

8" Pvc From SMH To 8"x6" Pvc Reducer.  
6" Cleanout

Railroad