


Sewer Connection

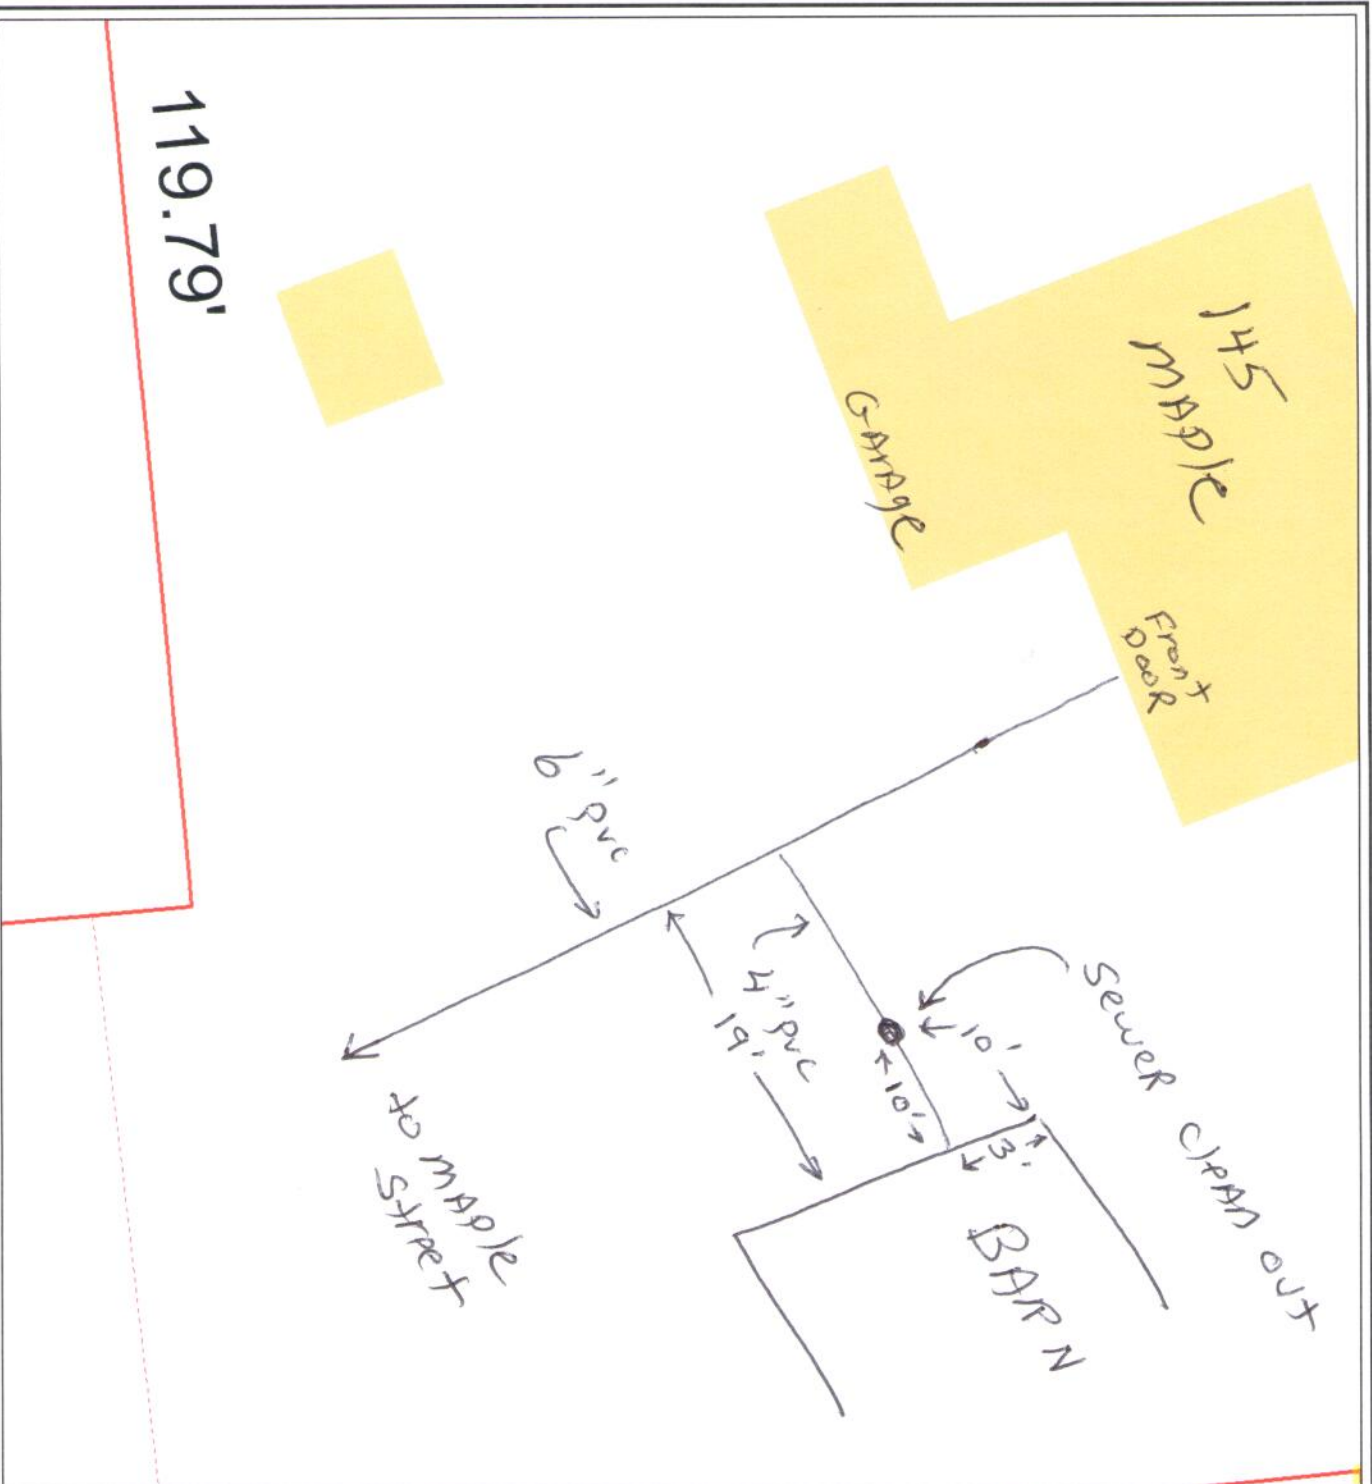

maps.eastlongmeadowma.gov

- Parcel Lines
 - Parcel Line
 - Boundary Line
 - Private ROW Line
 - Public ROW Line
 - Town Boundary Line
 - Other Boundary Line
- Former Parcel Lines
 - Former Lot Line
 - Former ROW Line
 - Former Paper ROW Line
 - Former Town Boundary
- Easement Boundaries
 - Town Boundaries
- Basemap
 - Road Edges
 - Driveways
 - Sidewalks
 - Parking Lots
 - Streams
 - Water Bodies
 - Swampy Areas
- MassGIS Layers
 - Buildings (2013)

The Town of East Longmeadow and its mapping contractors assume no legal responsibility for the information contained herein.



1" = 18 ft



August 4, 2016

119.79'