

No. Street 142


(San. Sewer)



Lot No.

Meadowbrook Road

Inspected

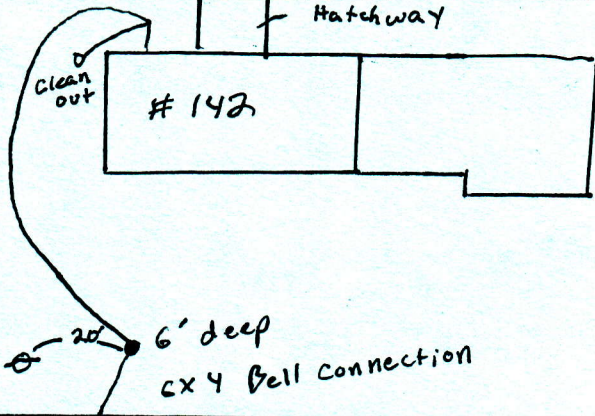

MH — 78'