


EAST LONGMEADOW DEPARTMENT OF PUBLIC WORKS

Job: 4 Melody lane (Sewer)
Sheet No: Sewer Main Repair of _____
Calculated By: Josh C. Date 3-9-17
Scale: Gas Co. Hit Sewer main with Bullet.

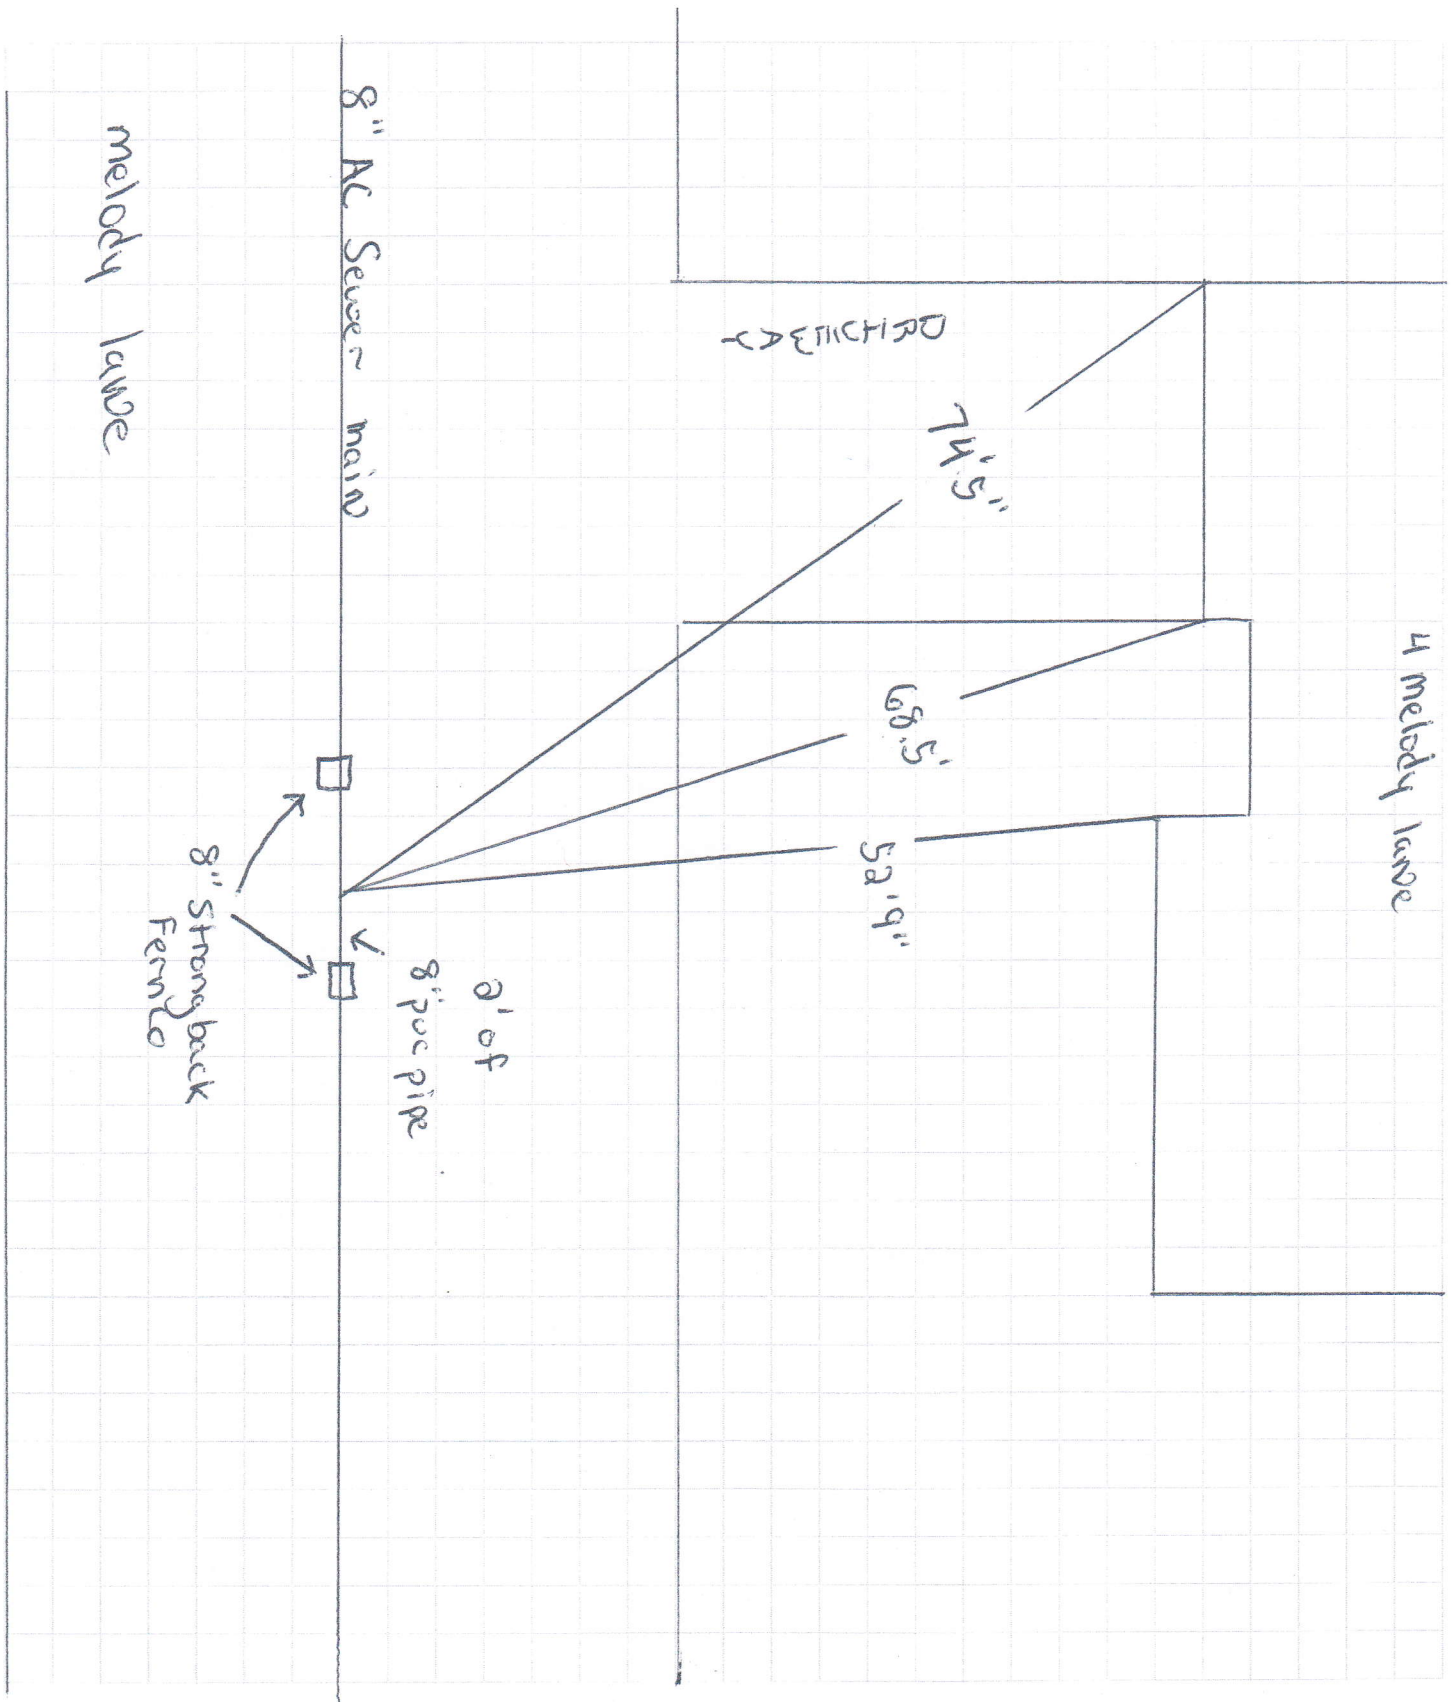

KAMAN

Automation, Control & Energy

MINARIK | ZELLER

KIT Zeller, Inc.

1000 University Ave.
Suite 800
Rochester, NY 14607

P 585.254.8840
F 585.254.0982

www.kamanace.com

Sewer
MH 2590

8' 3" deep

Dale St

24'-25'

8" PVC

← 8" Fernco
offset joint

8" AC

moose St Ext

7' deep

Sewer MH 2023

