



EAST LONGMEADOW DEPARTMENT OF PUBLIC WORKS

Job: 85 Melwood (Sewer) Repair

Sheet No: _____ of _____

Calculated By: Pope Date 10-6-2022


Scale: Excavator - Gary Turnburg

Melwood Ave

85 Melwood Ave

Sewer Repair

2-4" AC to pvc Strongback frames
4' of 4" pvc pipe
Depth - is 4'

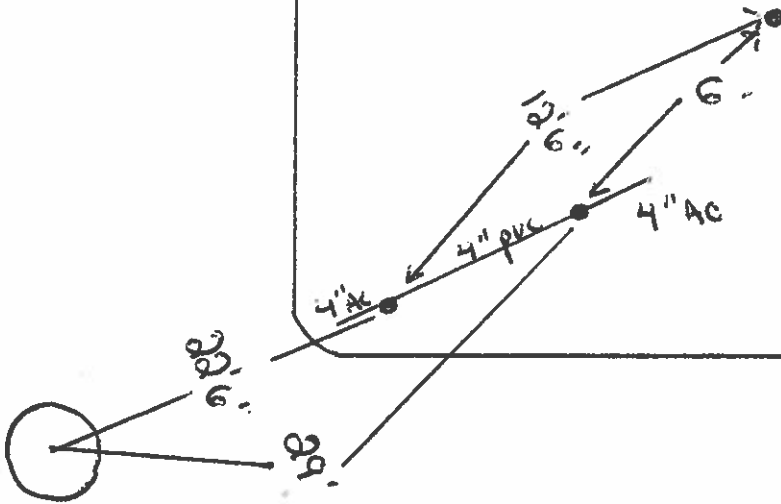

Sewer MH
#1879