




EAST LONGMEADOW DEPARTMENT OF PUBLIC WORKS

Job: Watchaug Forced MAIN REPAIR
Sheet No: _____ of _____
Calculated By: _____ Date 9-14-2021
Scale: _____

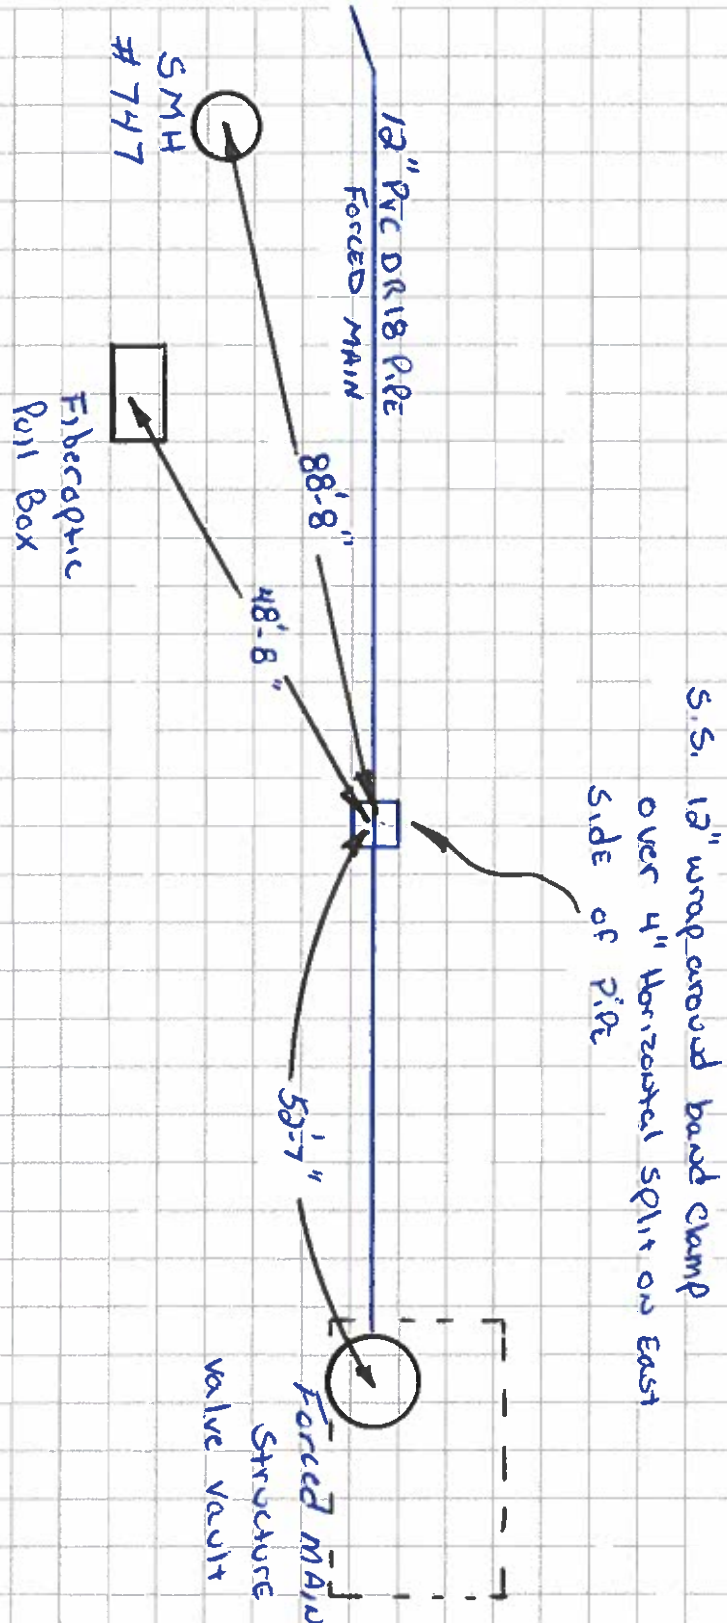

Groove on side of P.P.e appears to have been made by Excavator bucket tooth During original installation.