


No. Street 67 (San. Sewer) ☒ Lot No. 11/10/04
NEWBURY ST Inspected

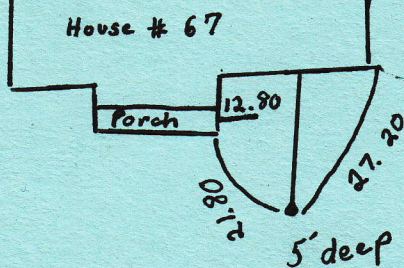

No. Street 73 (San. Sewer) 8/17/06 Lot No. Inspected
NEWBURY AVENUE

