




EAST LONGMEADOW DEPARTMENT OF PUBLIC WORKS

Job: 121 North Main St. (Sewer)

Sheet No: _____ of _____

Calculated By: Pope Date 5-25-2022

Scale: Excavator Always Reliable

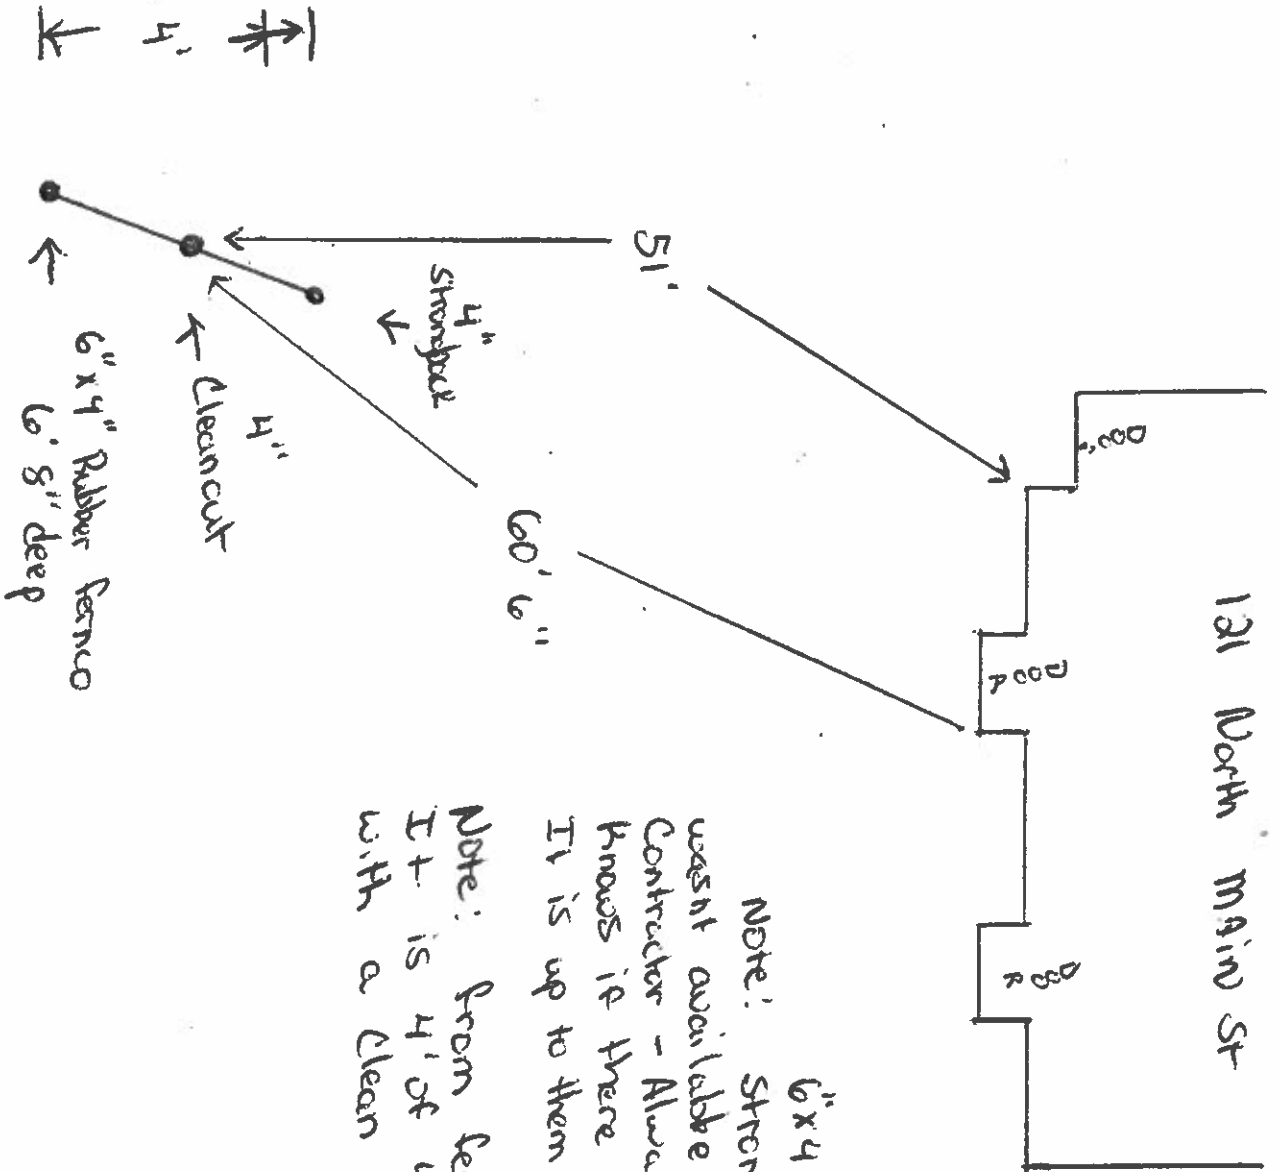

NOTE: Strongback Fernco
wasnt available at time of repair
Contractor - Always Reliable
knows if there is any issue
It is up to them to repair

NOTE: from fernco to fernco
It is 4' of 4" pvc pipe
with a clean out in the middle

North Main St.