


EAST LONGMEADOW DEPARTMENT OF PUBLIC WORKS

Job: 60 North Main St. (Sewer)

Sheet No: _____ of _____

Calculated By: Pope Date 1-31-17

Scale: _____

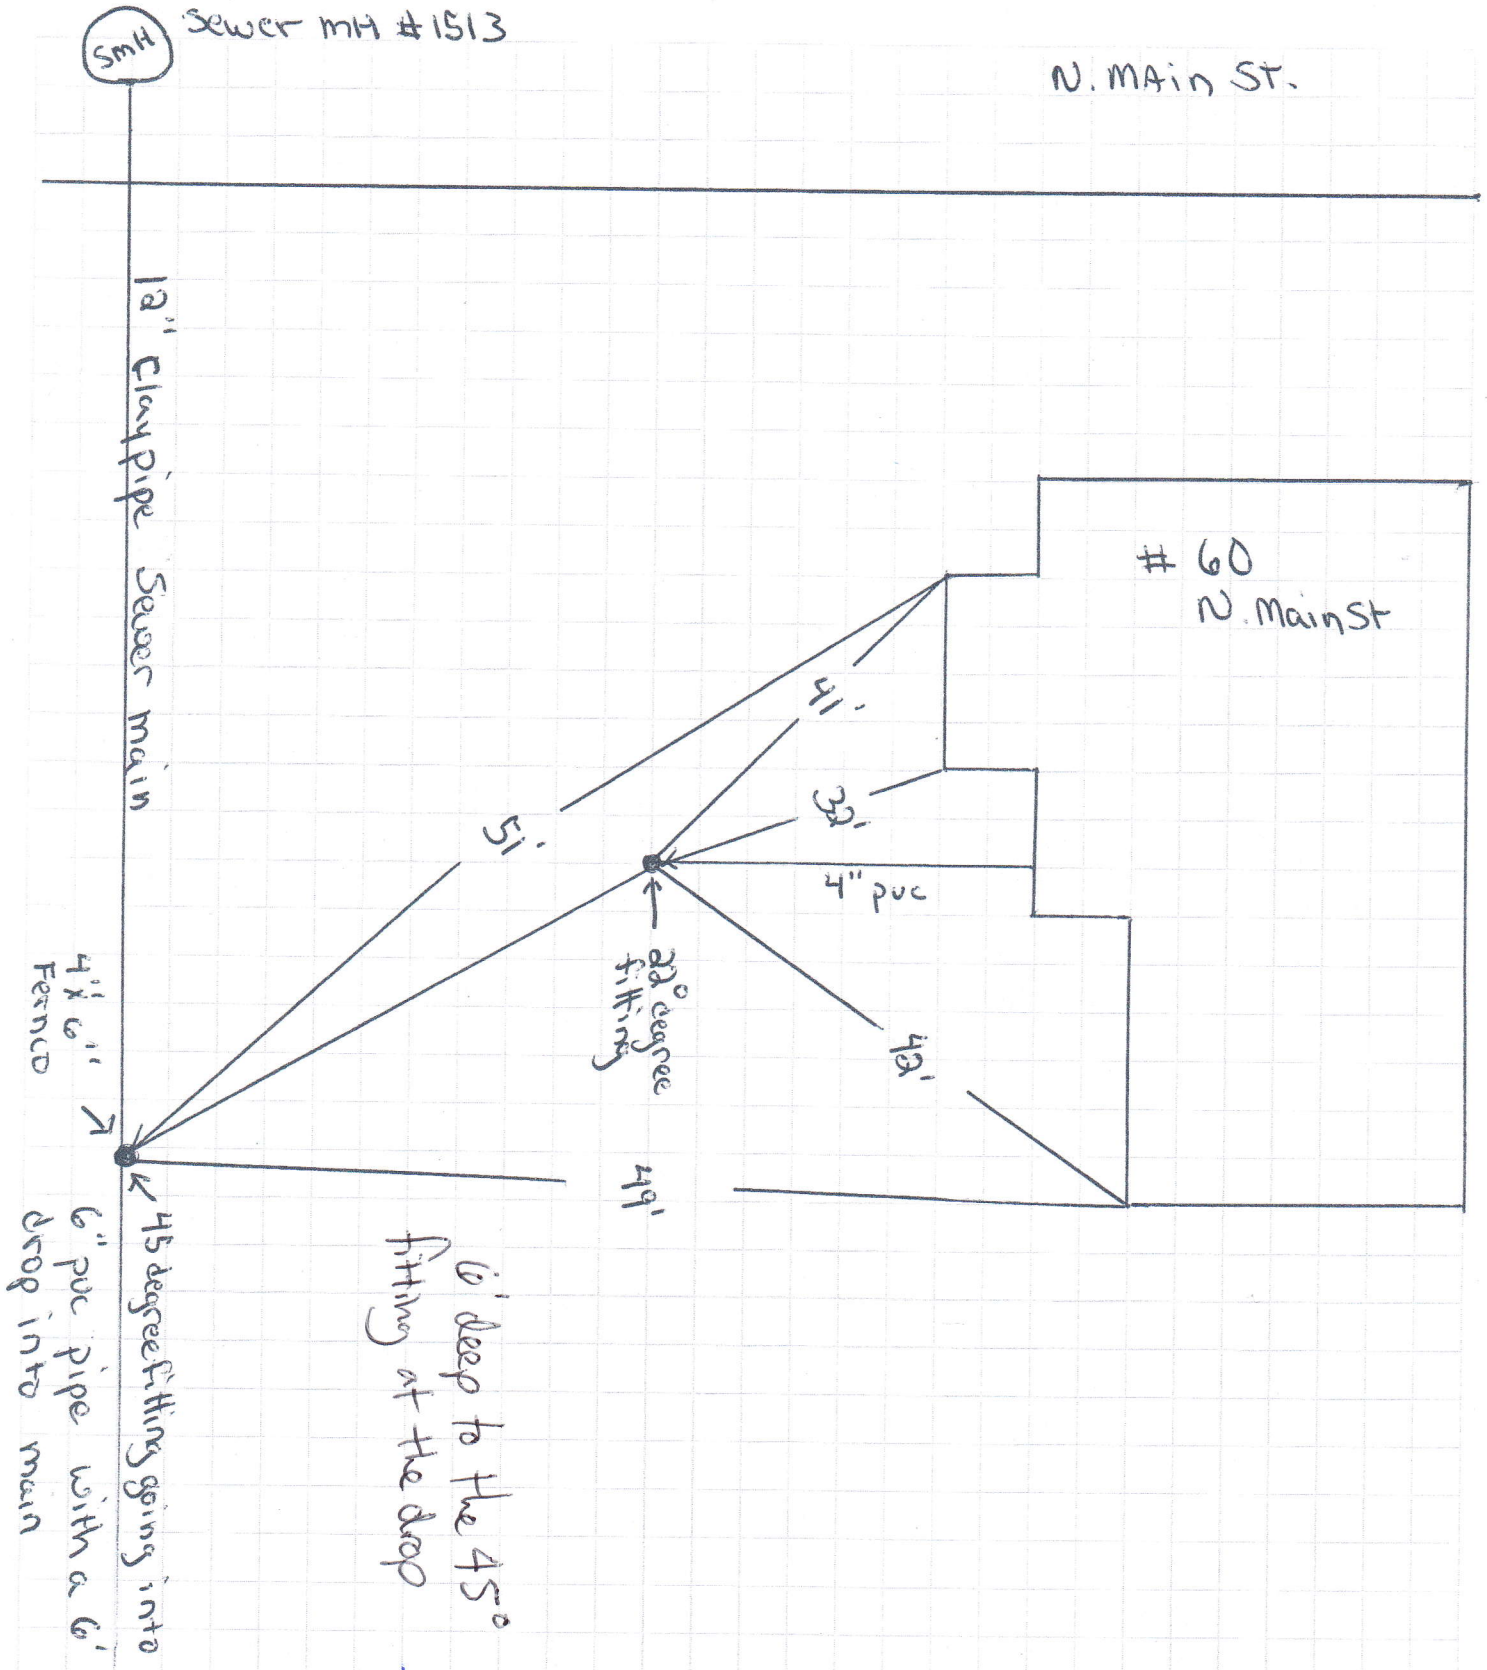

2/1/17 Scanned to GIS