


JOB: 6" SPWER CONNECTION

SHEET NO.: 61 & 61 R. North MAIN OF R2E

CALCULATED BY: _____ DATE: 6-30-2015

SCALE: _____

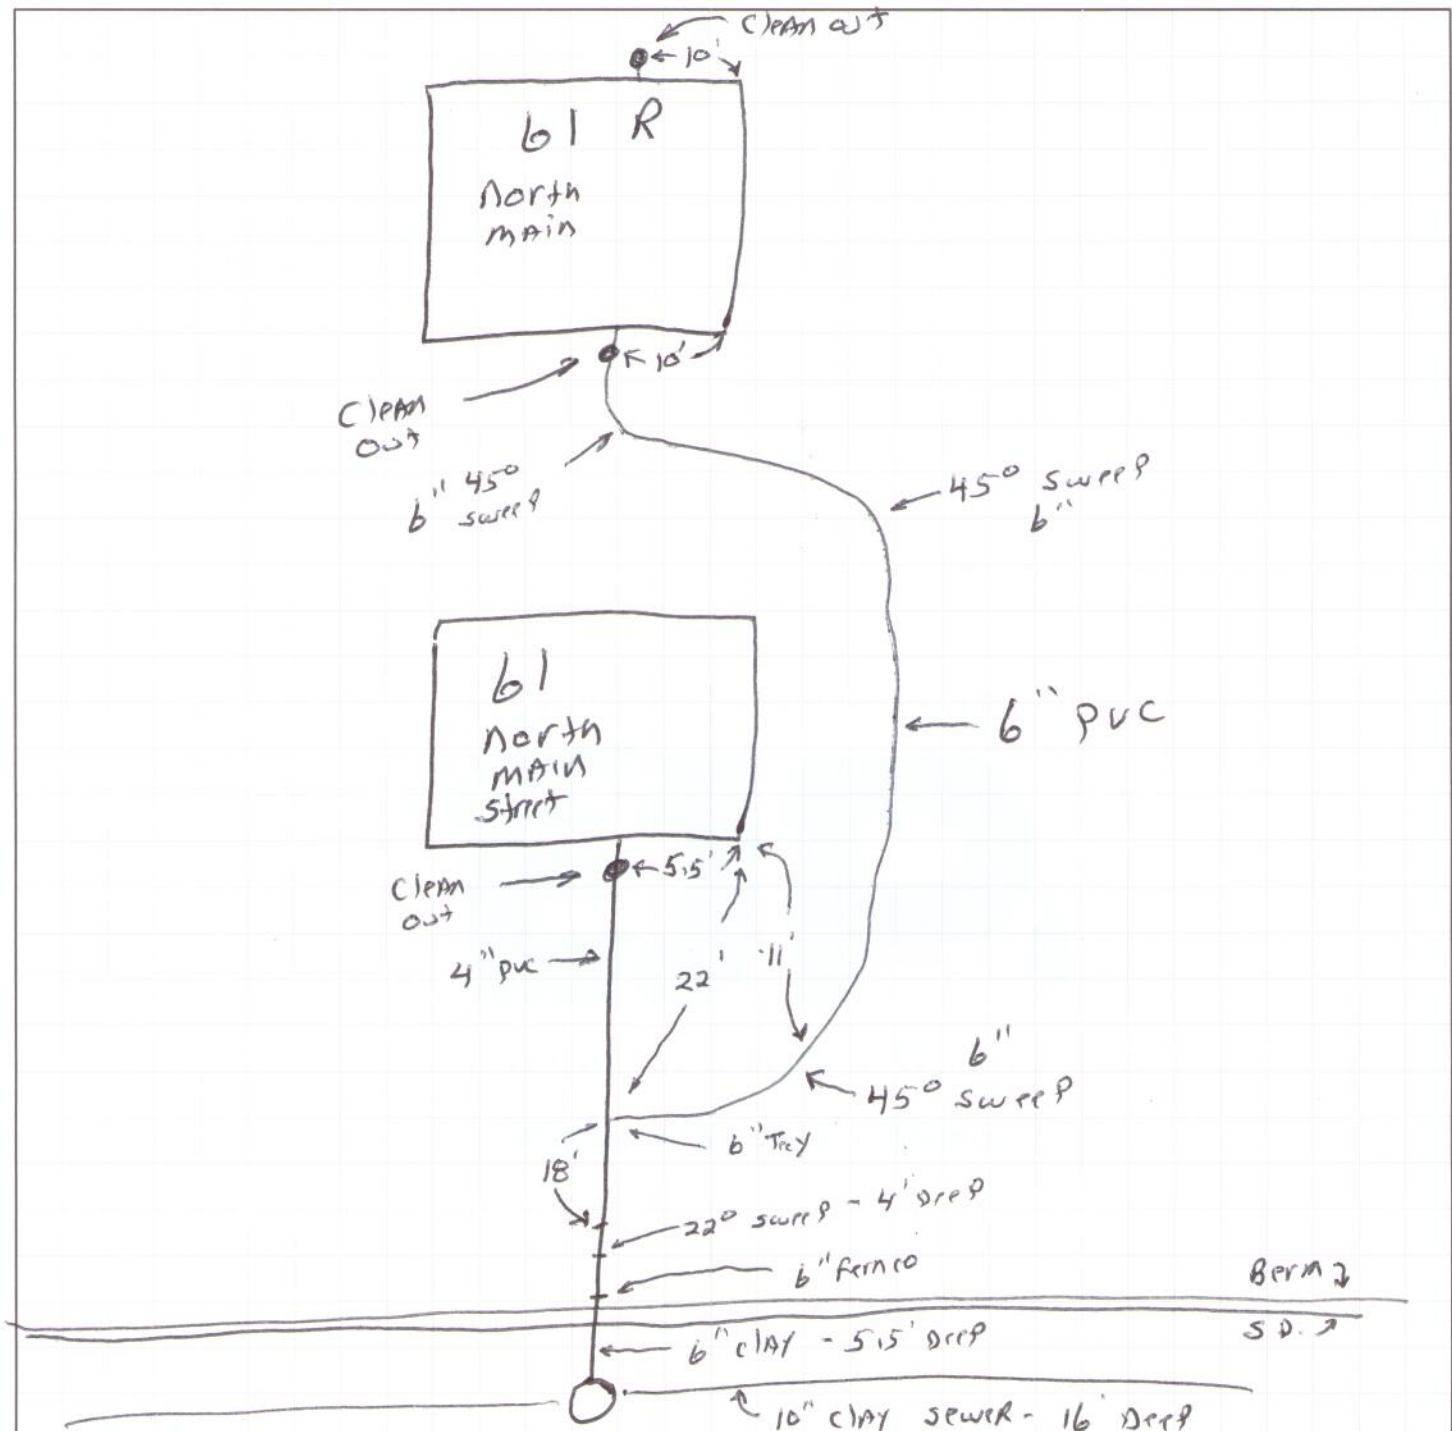

North main street