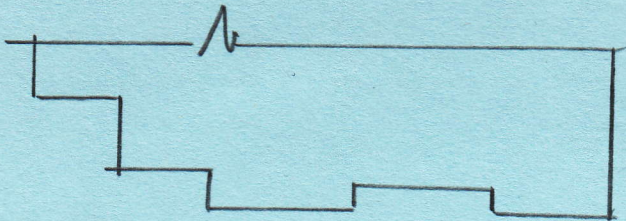


No. Street 20716 (San Sewer)

Lot No.

104 ORCHARD ROAD

Inspected

HYDRANT



CSMH#15