


No. Street 133 (San. Sewer) Lot No. 3/26/04  
ORCHARD RD. Inspected

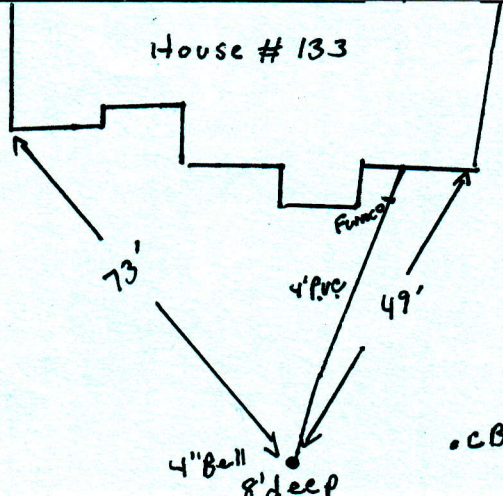

House # 133

73'

Function

4' PVC

49'

4" Ball

8' deep

.CB