

EAST LONGMEADOW DEPARTMENT OF PUBLIC WORKS


Job: 81 Parker St. (Sewer)

Sheet No: _____ of _____

Calculated By: Pope Date 5-1-18

Scale: _____

Parker St.

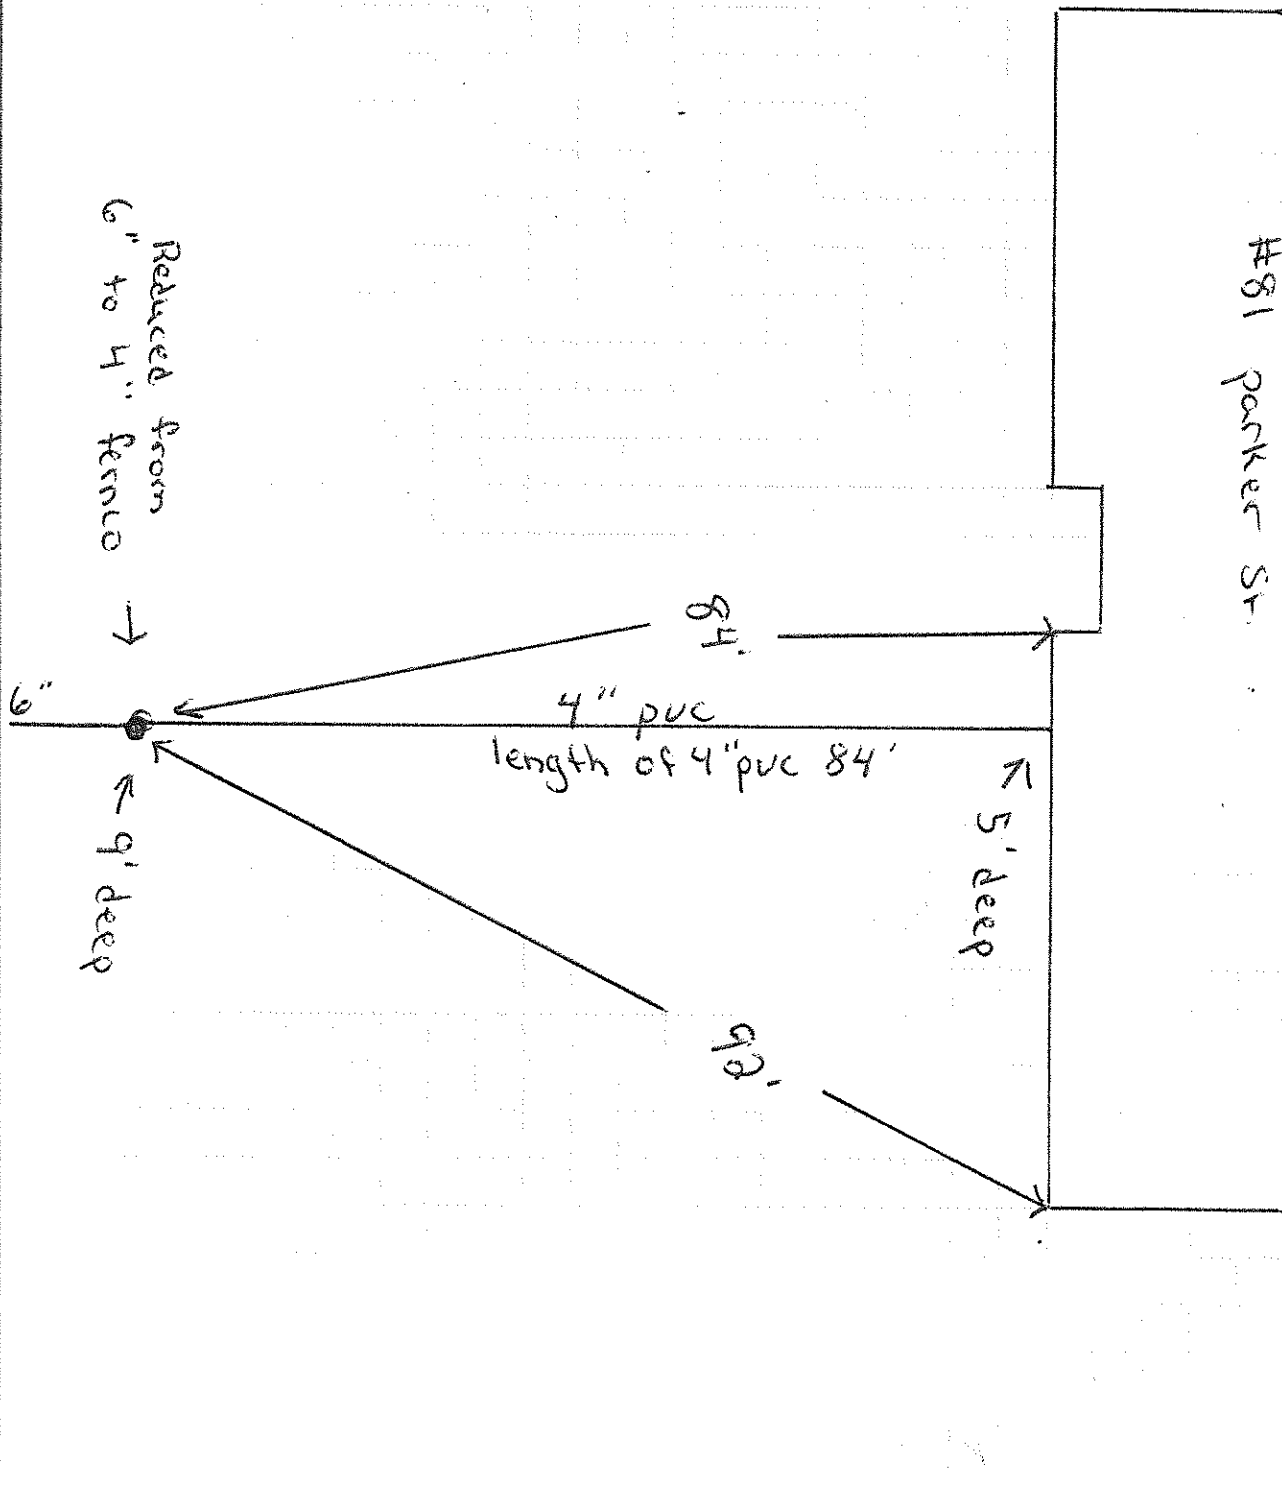

#81 Parker St.