

TOWN OF EAST LONGMEADOW DEPARTMENT OF PUBLIC WORKS 60 CENTER SQUARE EAST LONGMEADOW, MA 01028

Felix S. Vachon, Water & Sewer Administrator

felix.vachon@eastlongmeadowma.gov (413) 525-5400 ext. 1204

February 24, 2020

Re: 112 Parker Street

To whom it may concern,

The Property located at 112 Parker Street has connected to the Town's Sanitary Sewer System. The septic tank was pumped and crushed. A new 4" PVC pipe was laid to the Town's connection point at the property line. All aspects of the above were inspected by the Town inspector and approved.

Regards,

Felix Vachon

Water and Sewer Administrator

Loi S. O. Q. p.

Town of East Longmeadow Public Works



Hampden Septic, Inc.

100 Main Street • Hampden, MA 01036 413-566-2916 • fax 413-566-2965

		10
Customer		
Name	Hynda Eggn Ren	: Billy Bond
		,
	State MA ZIP 01028	
Phone		
Date	Description	Price
2/21/20	Pemped tank out.	
' /	Pemped tank out for sewer connection	
		8
	•	
		g. ·
·	Send reminder in year(s) Please keep this receipt for your records	•
1.	Anytime Exposed	<i>5</i> 7
Payment Do	Discount	
o Cash		
O Check	Total	350


Not responsible for any damage to sprinkler lines or heads incurred during excavation. A charge of 1 1/2% per month, 18% per annum will be added to accounts over 30 days.

Thank you for choosing Hampden Septic, Inc.!



EAST LONGMEADOW DEPARTMENT OF PUBLIC WORKS

Job: 112 Parker St	(Sewer)
Sheet No:	of
Calculated By: Pope	Date <u>2-21-2020</u>
Scale:	

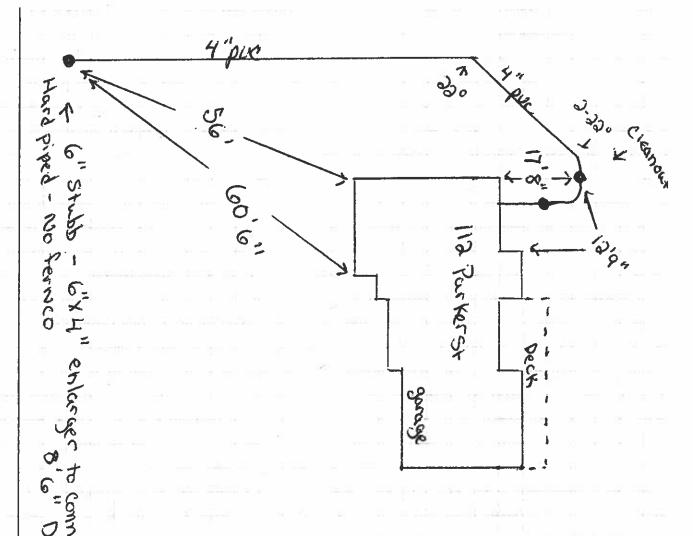

to the 6

Purker St

POS Reorder # 1923500