




EAST LONGMEADOW DEPARTMENT OF PUBLIC WORKS

Job: 113 Patterson Ave (Sewer)

Sheet No: _____ of _____

Calculated By: pope Date 10-4-17

Scale: _____

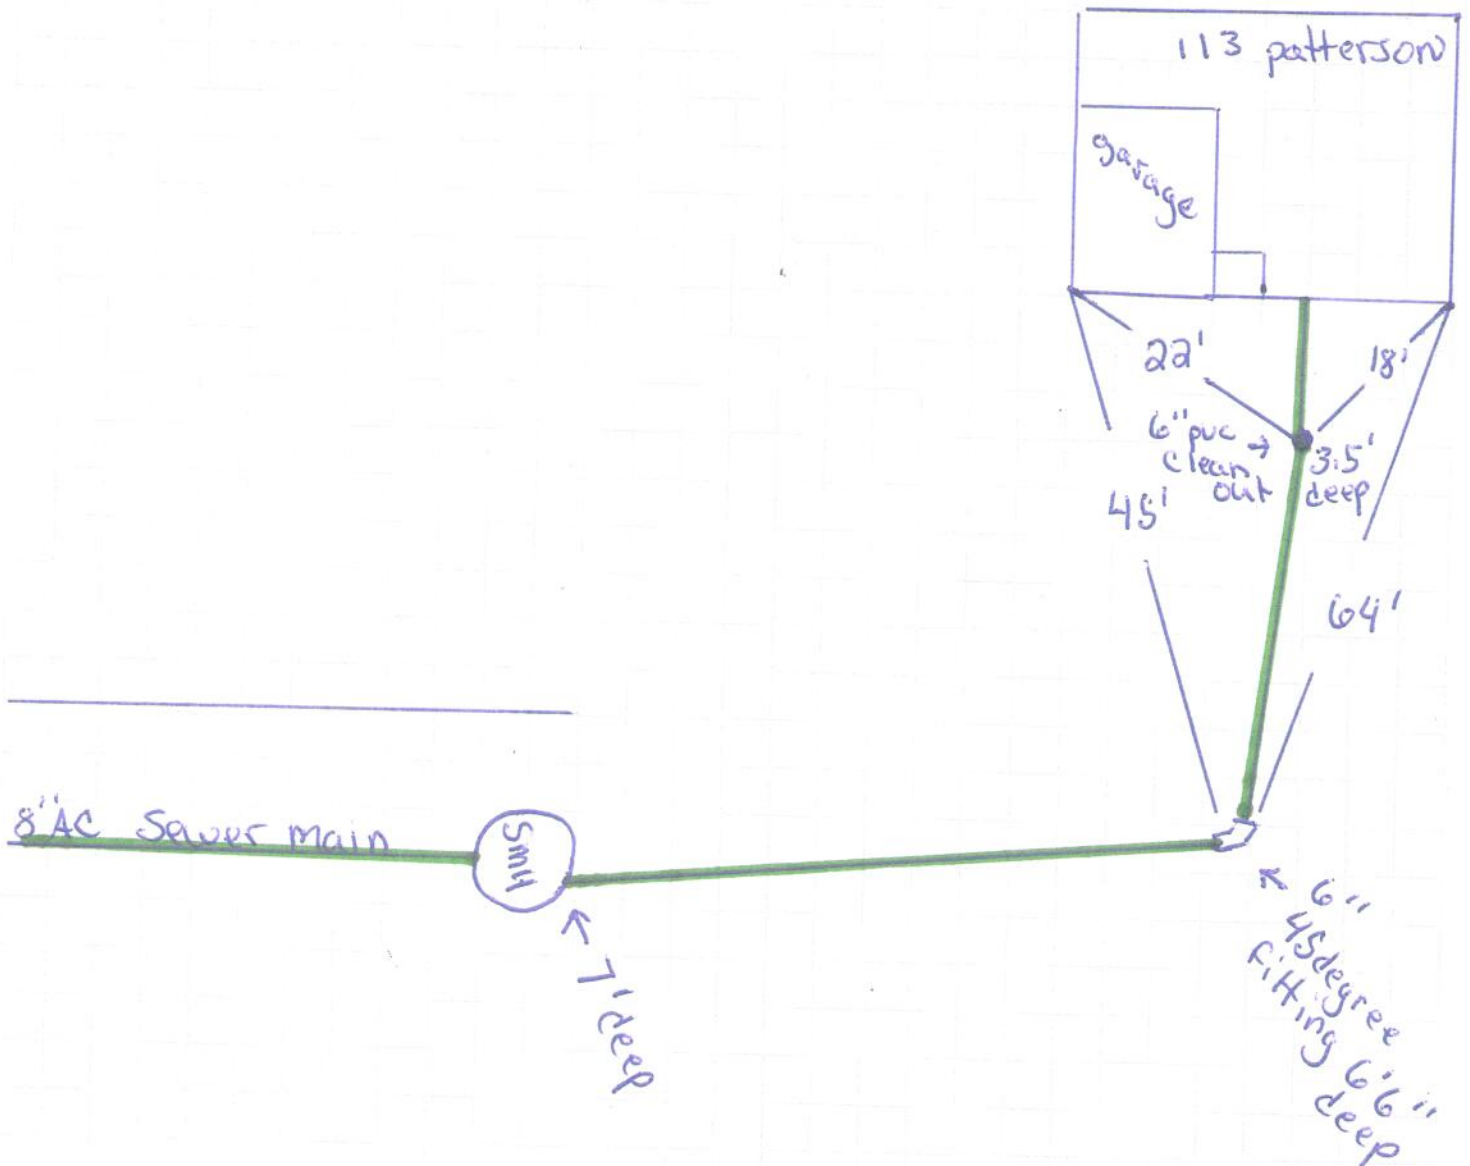

Patterson