


No. Street 17 PEAKTREE ROAD (San. Sewer) Lot No. 17
Inspected

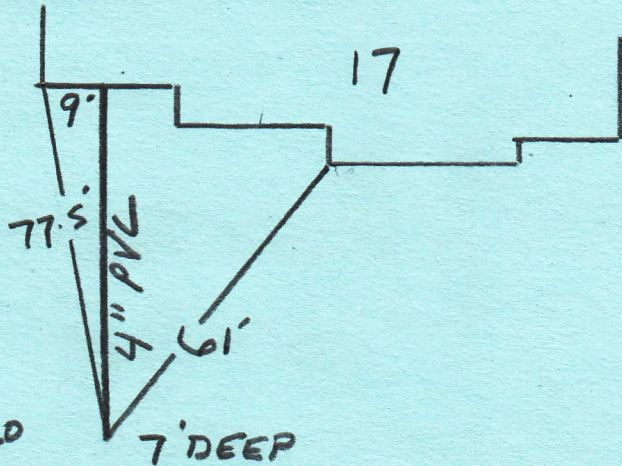

4" FERNLO