


Pembroke

Side wall

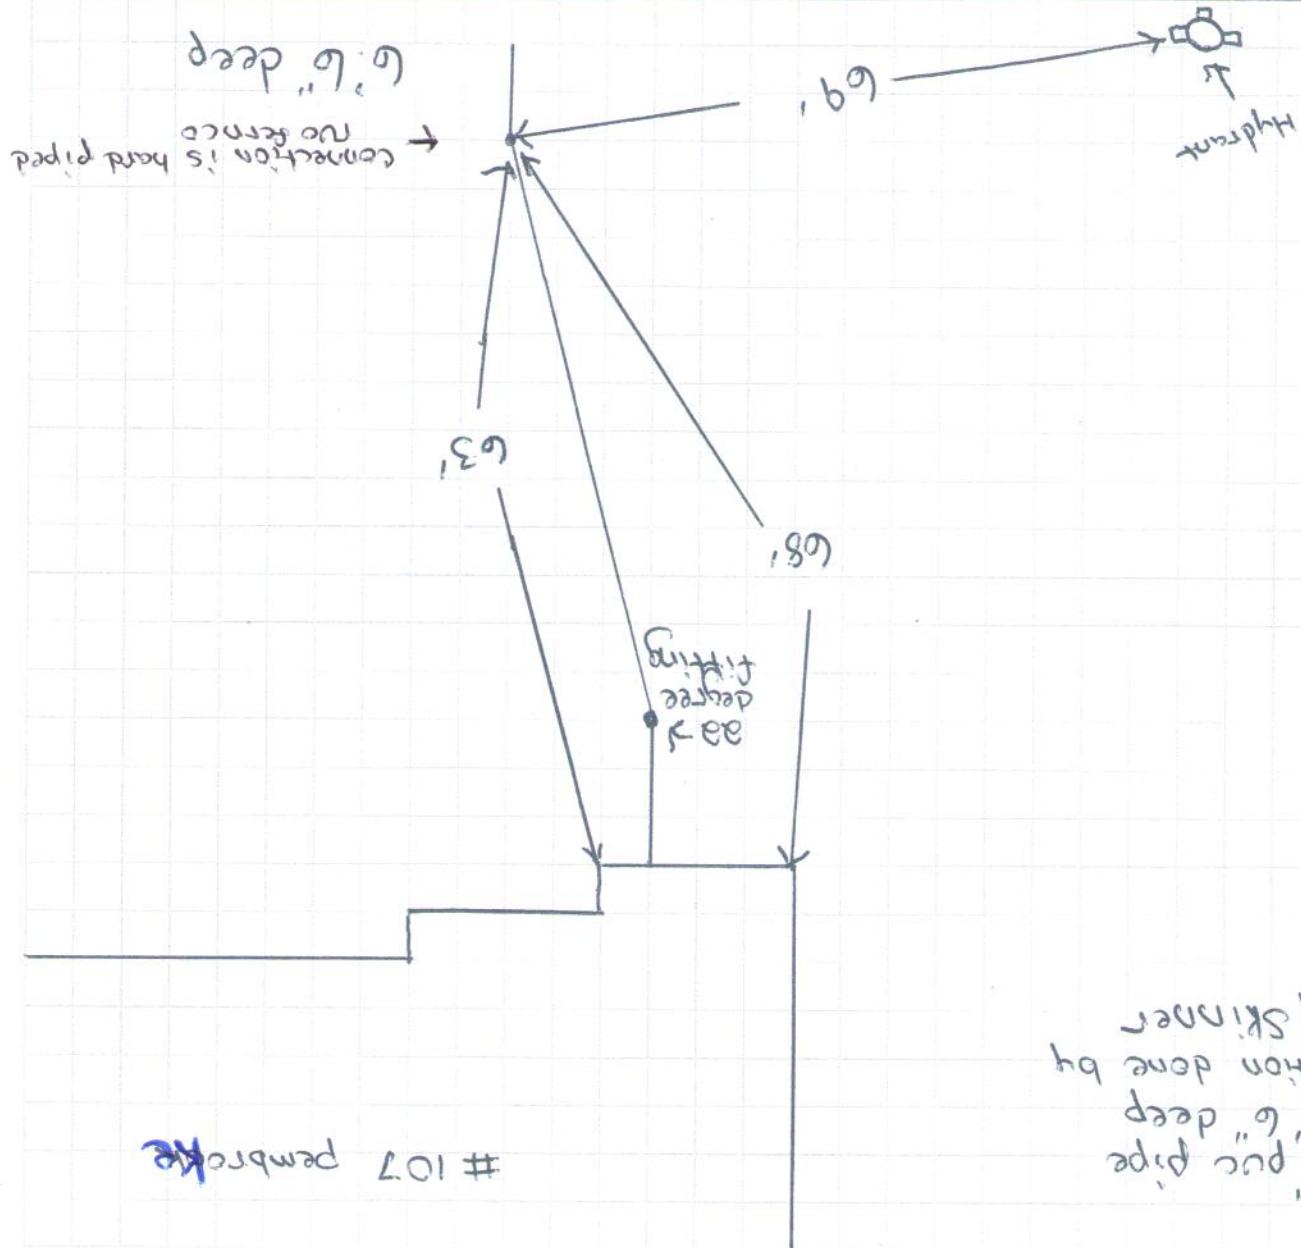

107 Pembroke

Excavation done by
B.L.I.Y Skinner
6' 6" deep
4' PUC Pipe

Scale: Excavator Skinner

Calculated By: Dope Date 6-23-16

Sheet No: 6' 6" deep 4' PUC Pipe of

Job: 107 Pembroke Sewer Ties

EAST LONGMEADOW DEPARTMENT OF PUBLIC WORKS

