




EAST LONGMEADOW DEPARTMENT OF PUBLIC WORKS

Job: 33 pondview (Sewer)

Sheet No: _____ of _____

Calculated By: Pope Date 9-8-17

Scale: Excavation by SKINNER

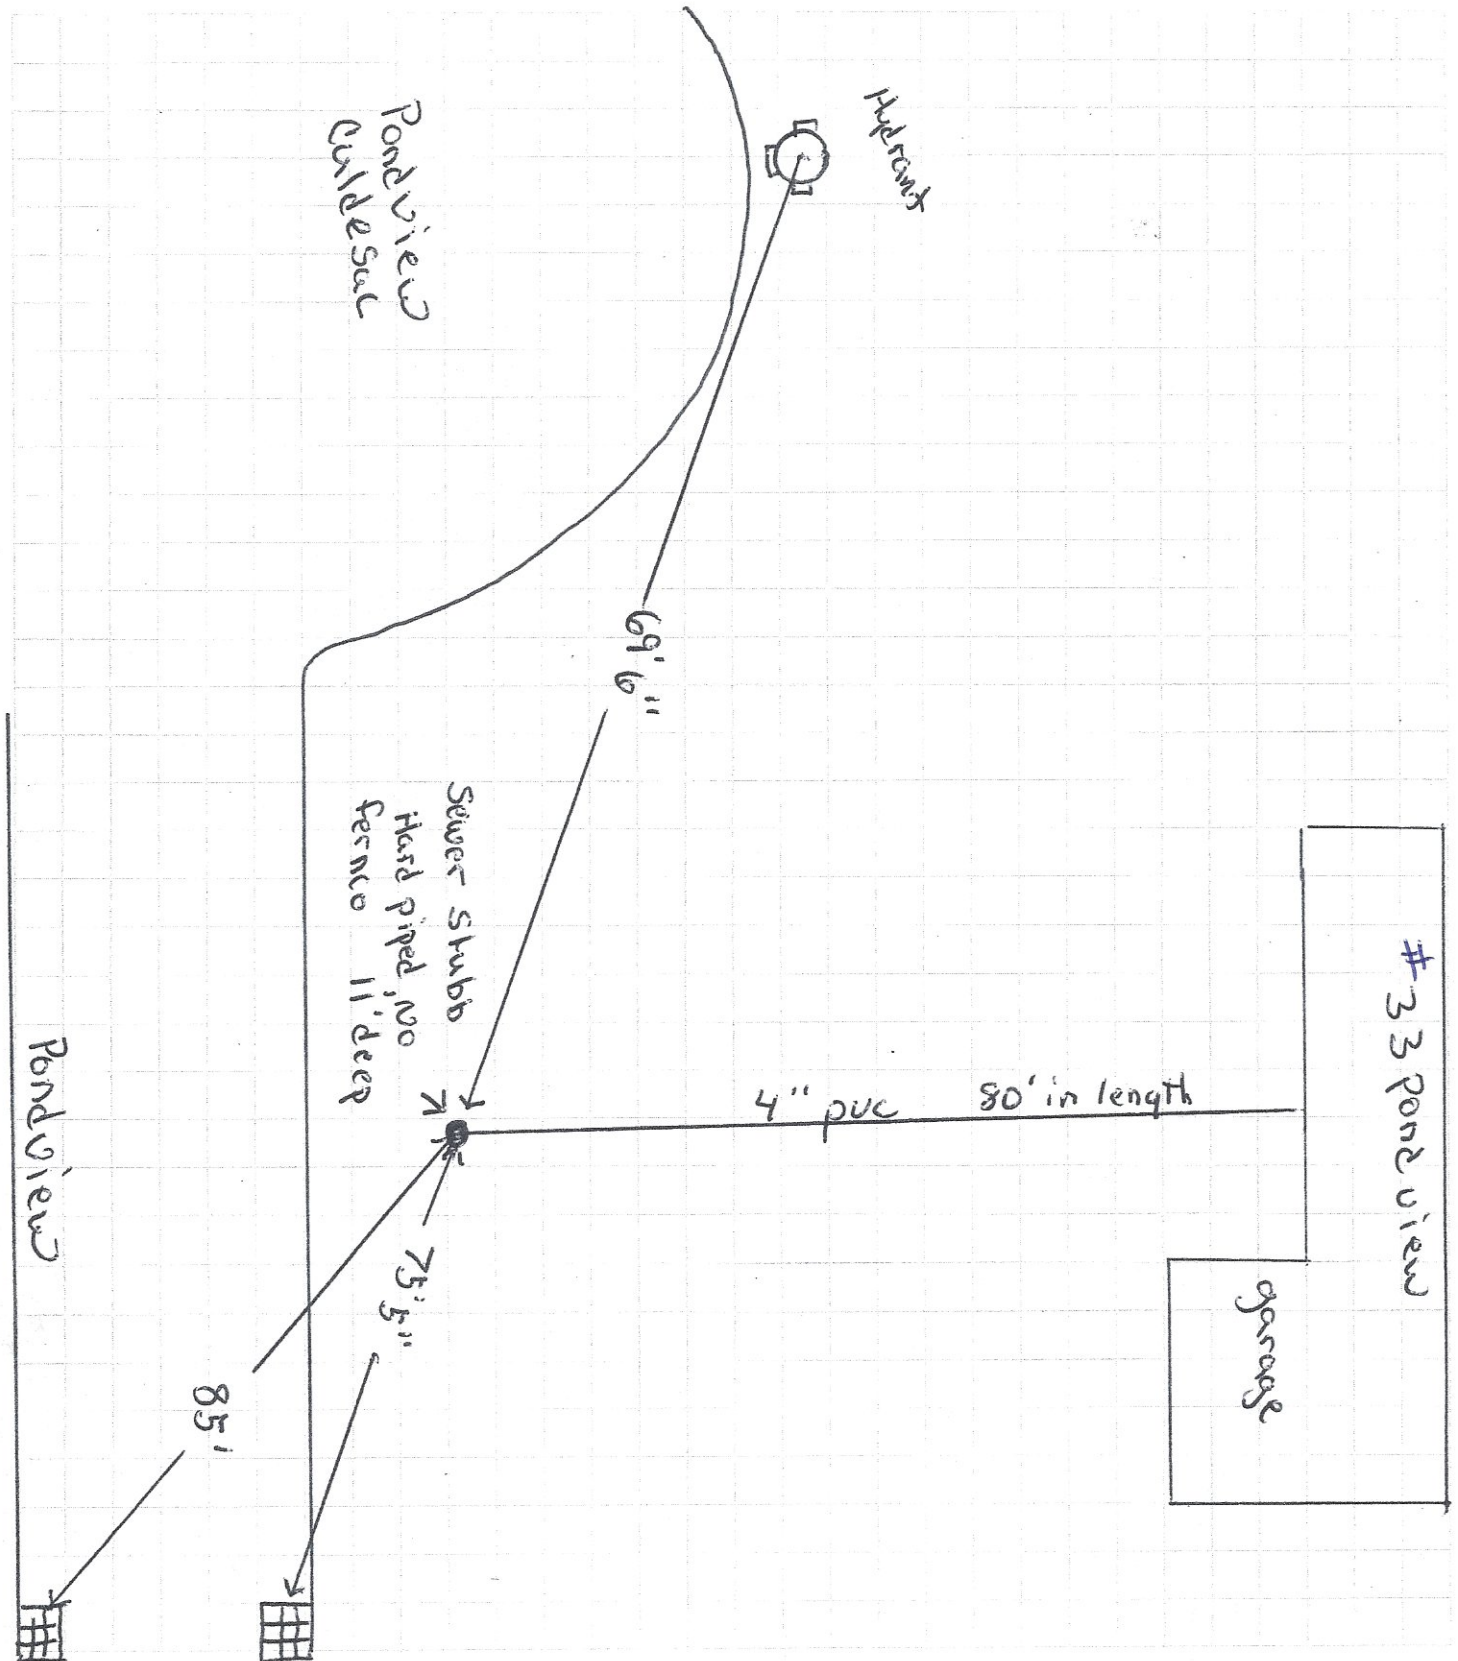

9/11/17 Scanned to GIS