


No. Street (San. Sewer) Lot No.
42 PROSPECT HILLS DR. Inspected 10-20-09

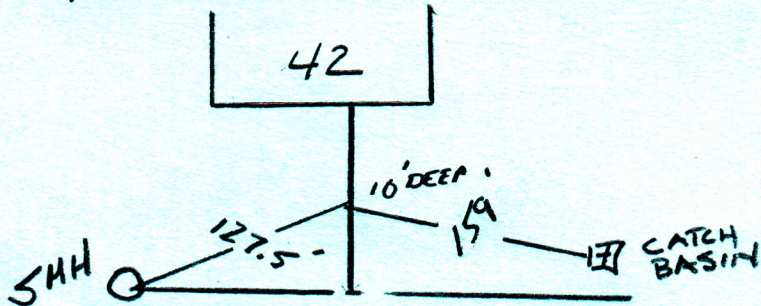

PROSPECT HILLS DRIVE