


Sewer

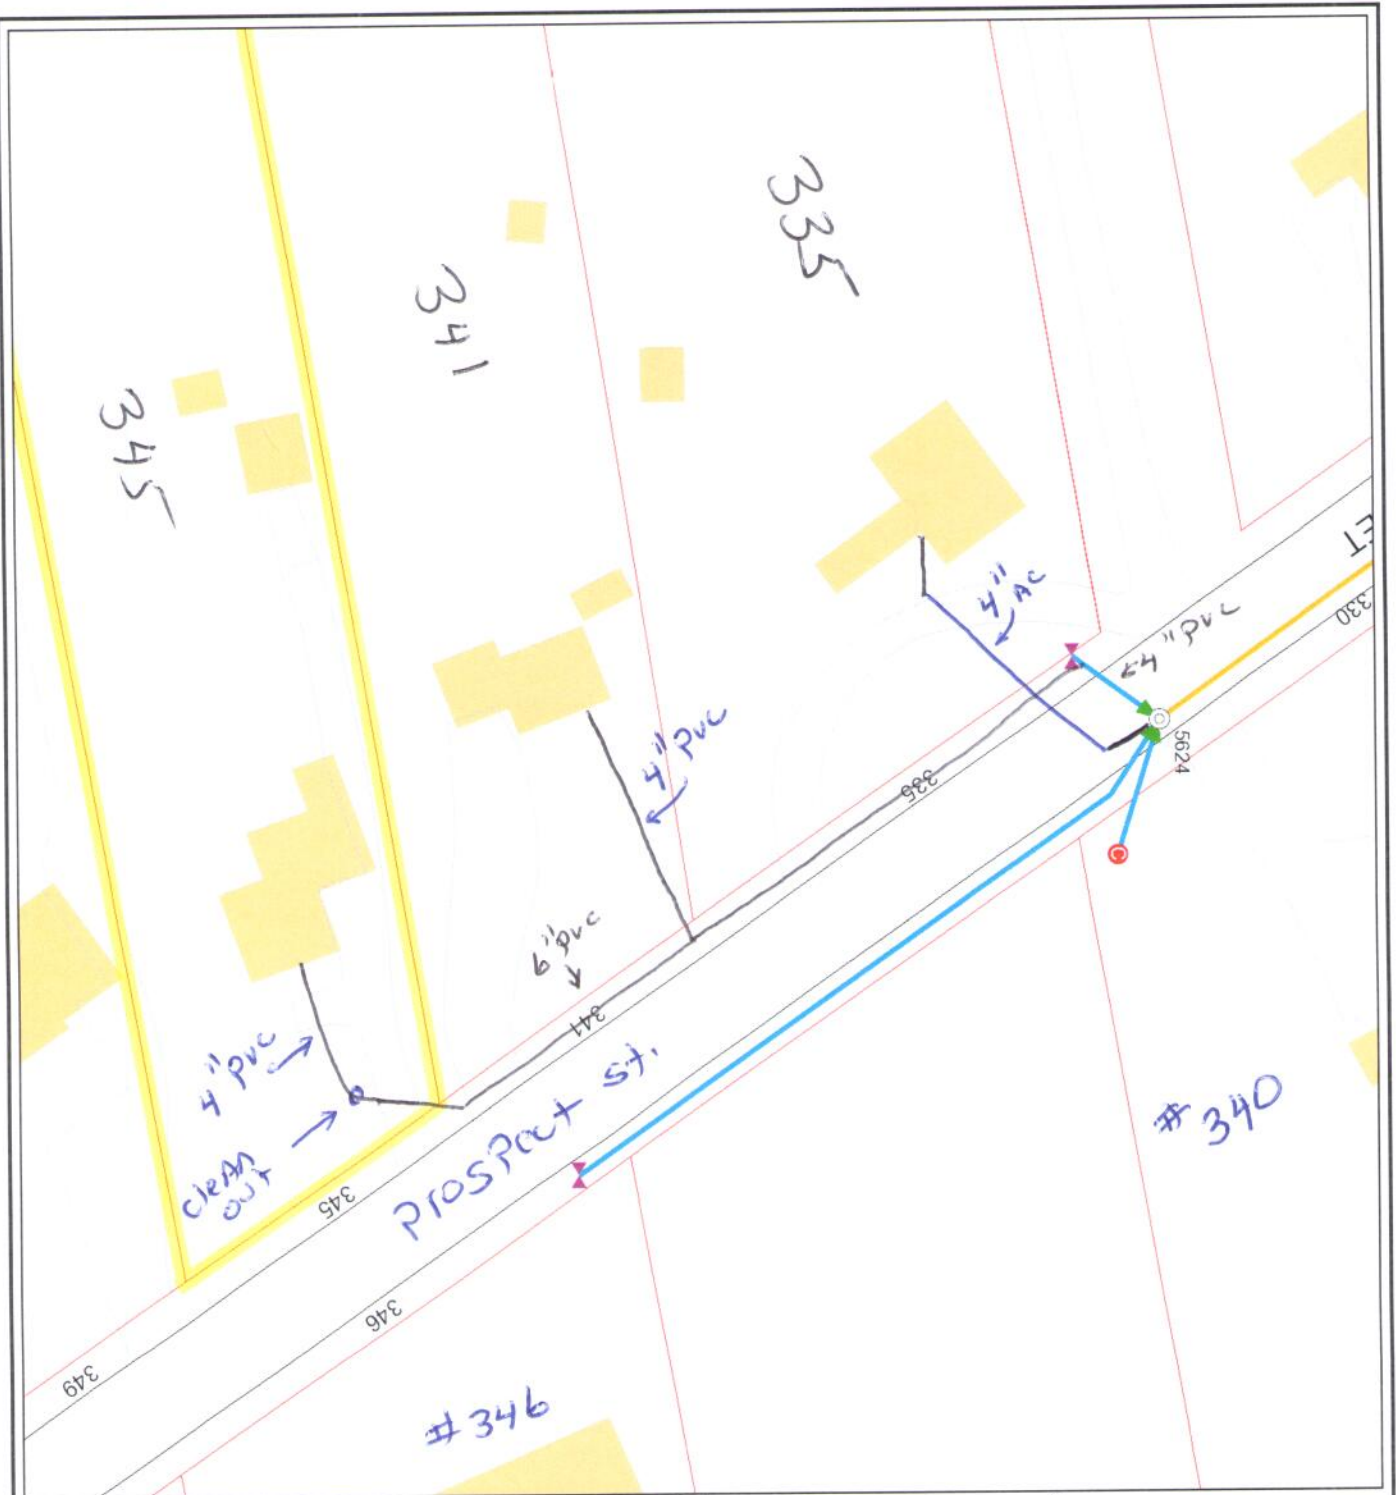

maps.eastlongmeadowma.gov

Sewer System

- Sewer Manholes
 - Sewer Connections
 - Sewer Features
 - Other Features
 - Wet Well
 - Pump Station
 - Sewer Fittings
 - Other Fittings
 - Bend fitting
 - Tee Wye
 - Cap fitting
 - Tee fitting
 - Wye fitting
 - Clean-out fitting
 - Chimney fitting
 - Reducer
 - Sewer Laterals
 - Sewer Mains
 - Gravelly
 - Forced Main
 - Easement Boundaries
 - Town Boundaries
- Base map
- Road Edges
 - Driveways
 - Sidewalks
 - Parking Lots
 - Streams
 - Water Bodies
 - Swampy Areas
- Disclaimer:** East Longmeadow and its officials and employees assume no legal responsibility for the information contained herein.



1" = 59 ft



October 11, 2016