




EAST LONGMEADOW DEPARTMENT OF PUBLIC WORKS

Job: Sewer Lateral
Sheet No: 526 prospect of _____
Calculated By: CHAD Date 3-16-2016
Scale: 4" PVC



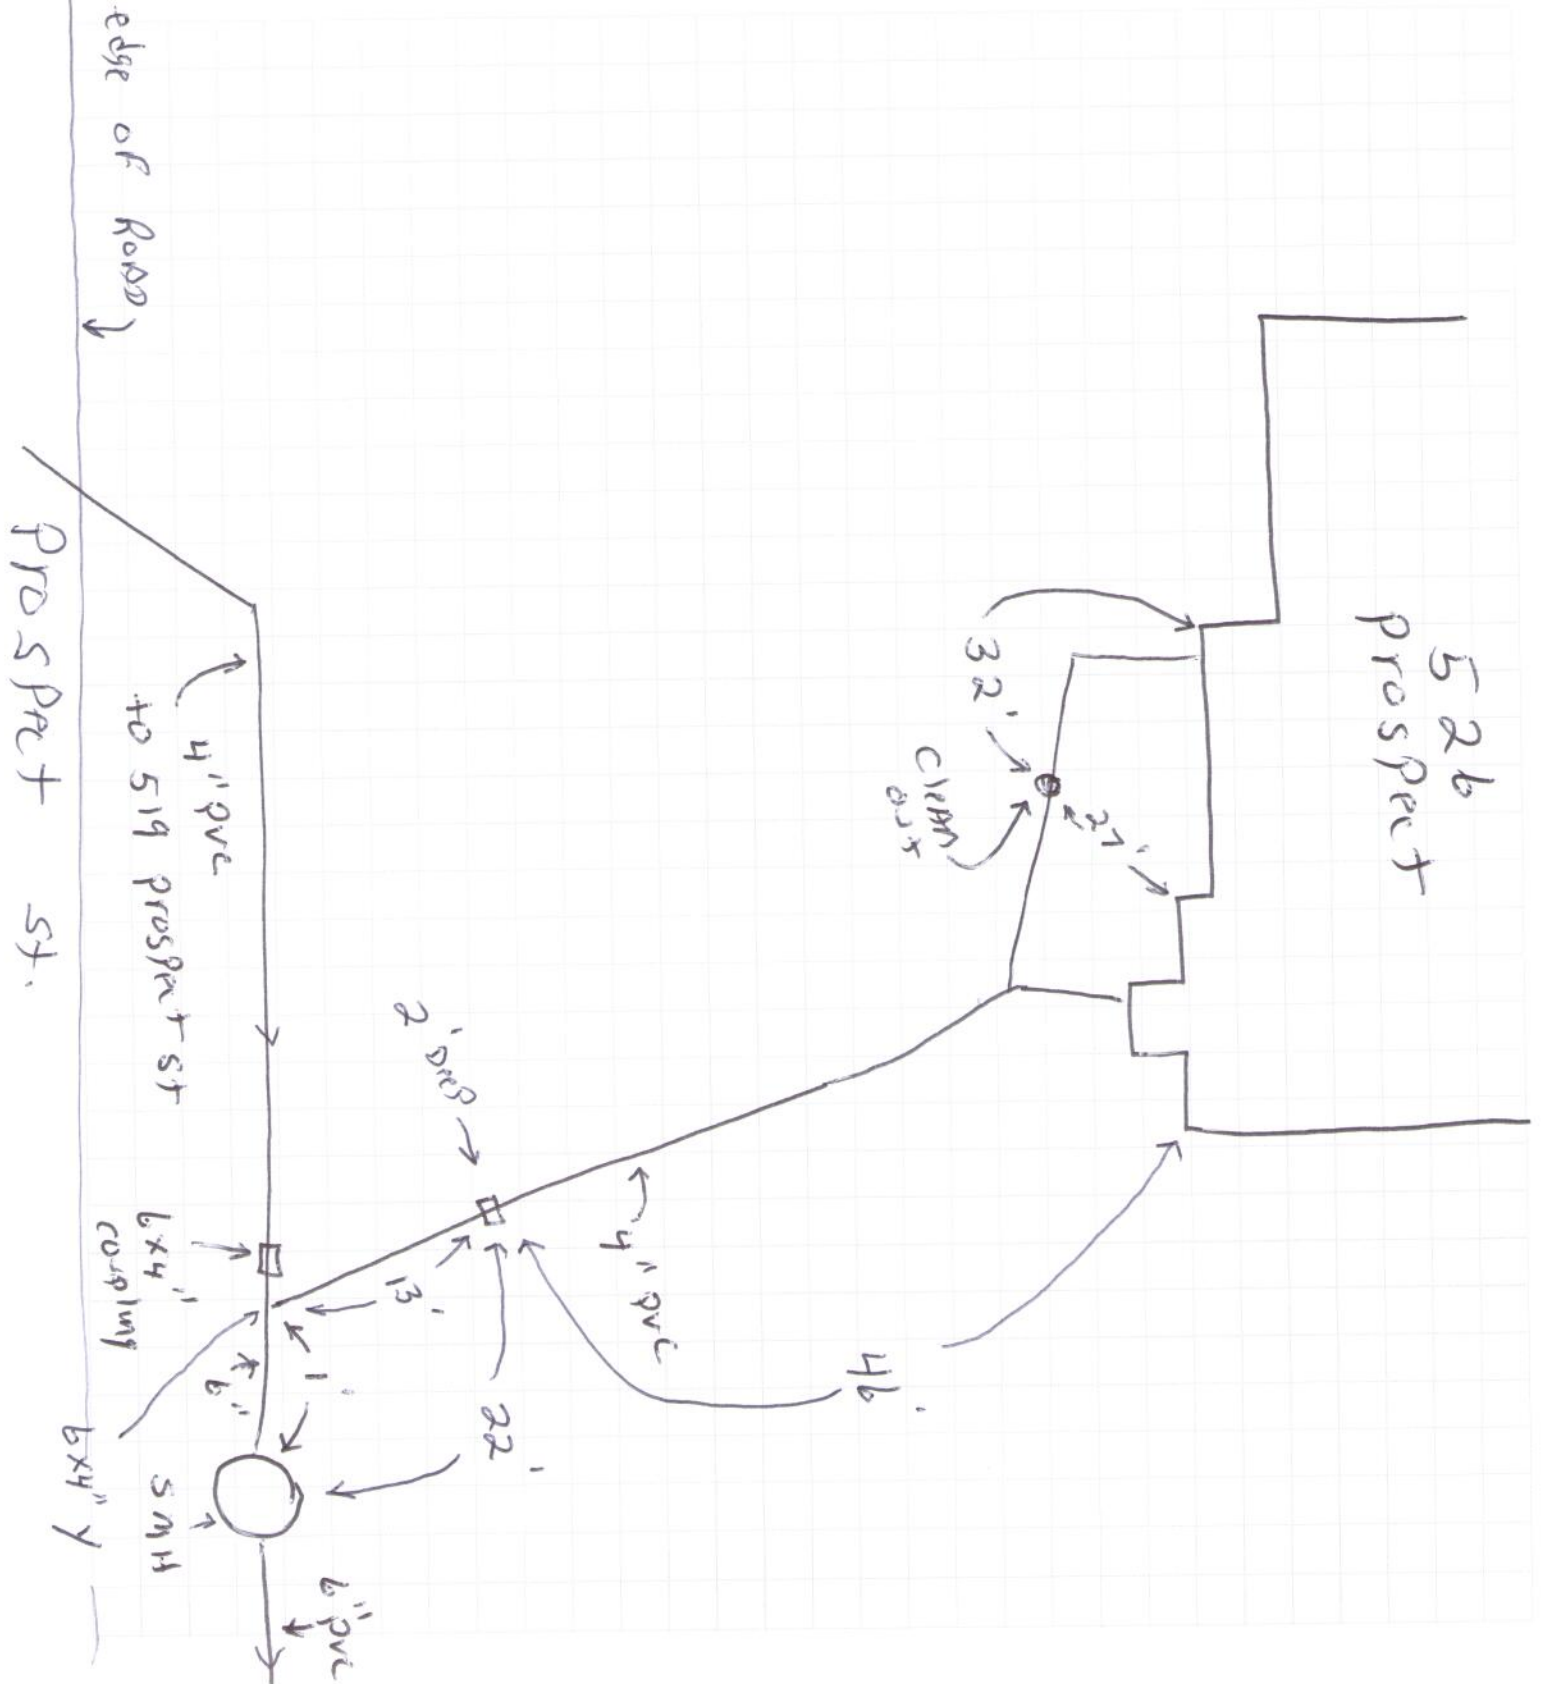

EAST LONGMEADOW DEPARTMENT OF PUBLIC WORKS

Job: Water

Sheet No: 526 Prospect St. of

Calculated By: Chad. R Date 3-17-2016

Scale:

Prospect St.

