


No. Street (San. Sewer) Lot No.
4 RAMONAS WAY Inspected 8-18-09

PARKER ST

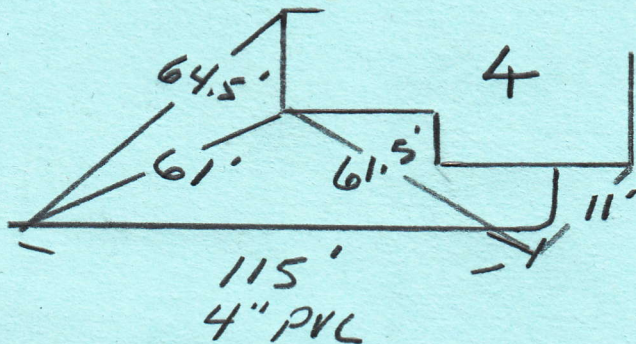

RAMONAS WAY