


No. Street

(San. Sewer)

Lot No.

116 RAMONA'S WAY

Inspected 4-17-13

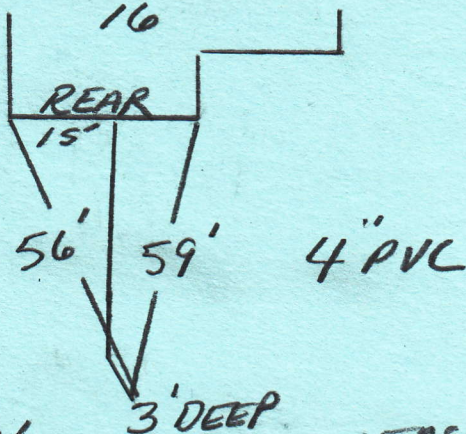

SANITARY

EASEMENT