


JOB: 40 Redstone Sewer inspection
SHEET NO.: _____ OF _____
CALCULATED BY: J. Fois DATE: 5/18/20
SCALE: _____

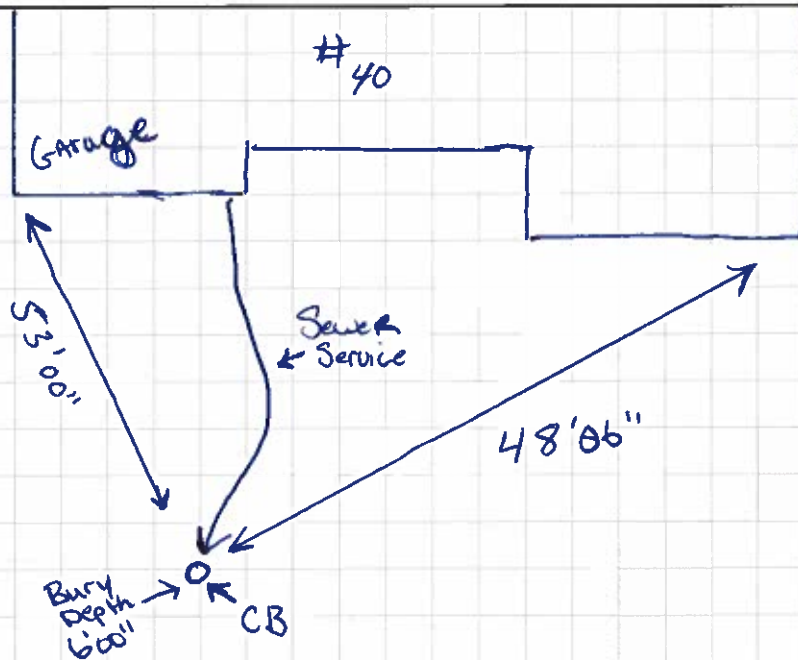

1 1/4" pvc Forced