


No. Street

(San. Sewer)

Lot No.

87 RIDGE ROAD

Inspected 8-20-12

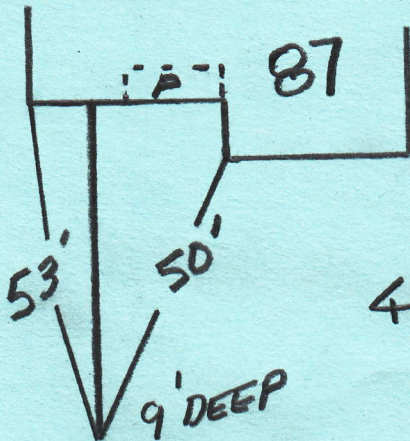

4" PVC