


EAST LONGMEADOW DEPARTMENT OF PUBLIC WORKS

Job: 5 Robin St. (Sewer)
Sheet No: Holcomb Farms - Excavator of _____
Calculated By: Pope Date 10-18-21
Scale: _____

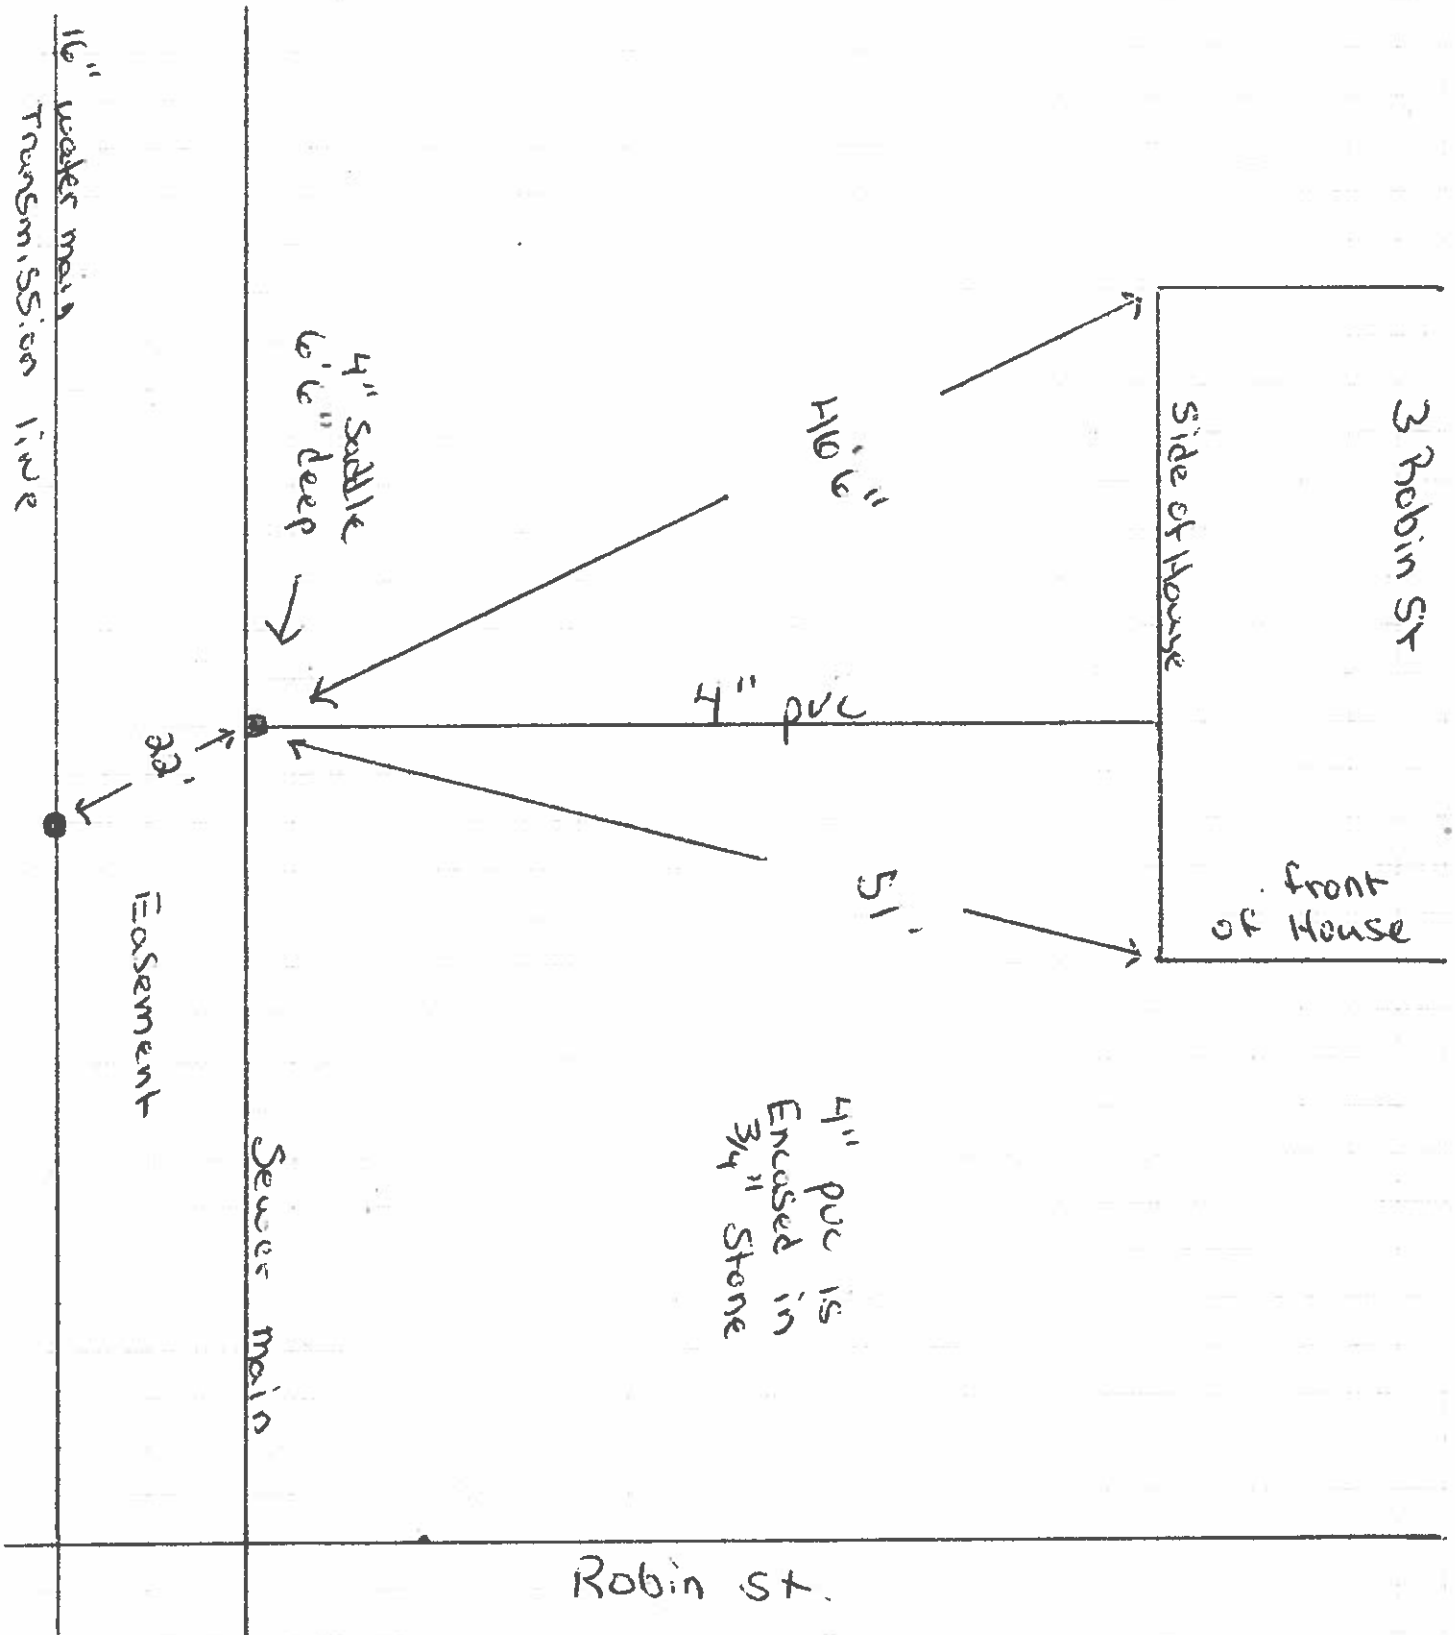

**TOWN OF EAST LONGMEADOW, MA
DEPARTMENT OF PUBLIC WORKS
SEWER INSPECTION**

DATE: 10-18-2021

Sanitary

Storm

Other

Size 4"

Fee \$50.00

Inspected Yes

LOCATION OF PROPERTY: 5 Robin St

OWNER:

Is drain under cellar floor

Feet above cellar floor

If building has cellar or footing drains, where do they discharge:

The above fee is for the initial inspection. If initial inspection is not approved, there will be an additional fee of \$25.00 for each inspection.

It is understood that only sanitary waste is to be connected to the sanitary sewer and only clean surface or sub-surface water to storm drain.

Thomas W. Pope
DPW Inspector