


No. Street Lot V-5 (San Sewer)

Lot No.

19 ROCKINGHAM CIRCLE


Inspected

HOUSE
BUILT

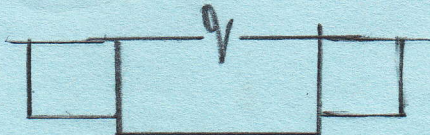

SMH-15

SMH-14

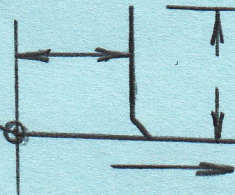

SMH-13