

No. Street

(San. Sewer)


Lot No.

81 SCANTIL DRIVE

Inspected

9-27-10

GLEN HEATHER LN.

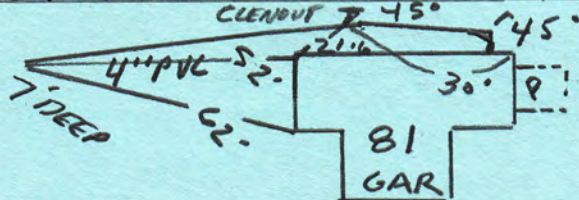

SCANTIL DRIVE

NO. STREET


DATE INST:

MAKE:

SIZE

81 Scantic Drive

SCANTIC DRIVE

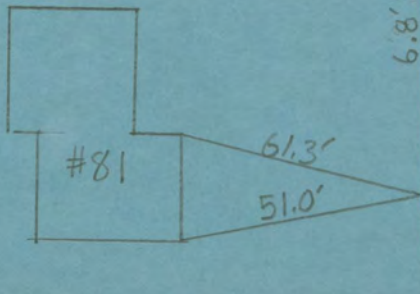

GLEN HEATHER LANE