


EAST LONGMEADOW DEPARTMENT OF PUBLIC WORKS

Job: 124 Shaker Rd. (Sewer)

Sheet No: Steve Santos (Excavator) of _____

Calculated By: Pope Date 4-25-19

Scale: _____

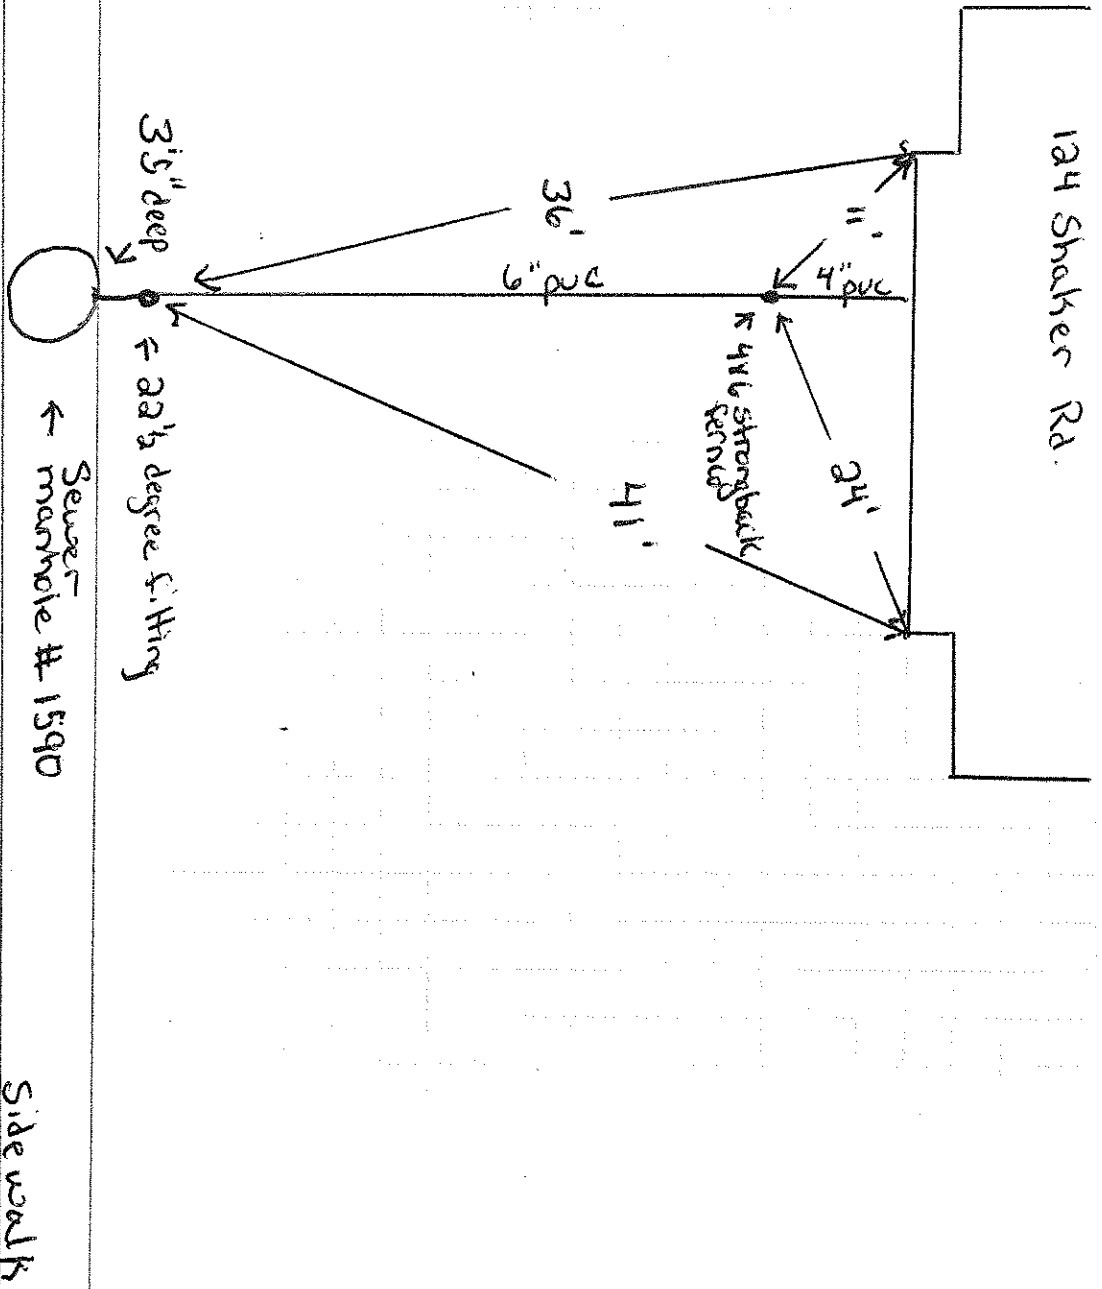

Shaker Rd.

Side walk