



EAST LONGMEADOW DEPARTMENT OF PUBLIC WORKS

Job: 227 Shaker Rd. (Sewer)
Sheet No: (Gas Station) of _____
Calculated By: Josh C. Date 2-8-17
Scale: _____

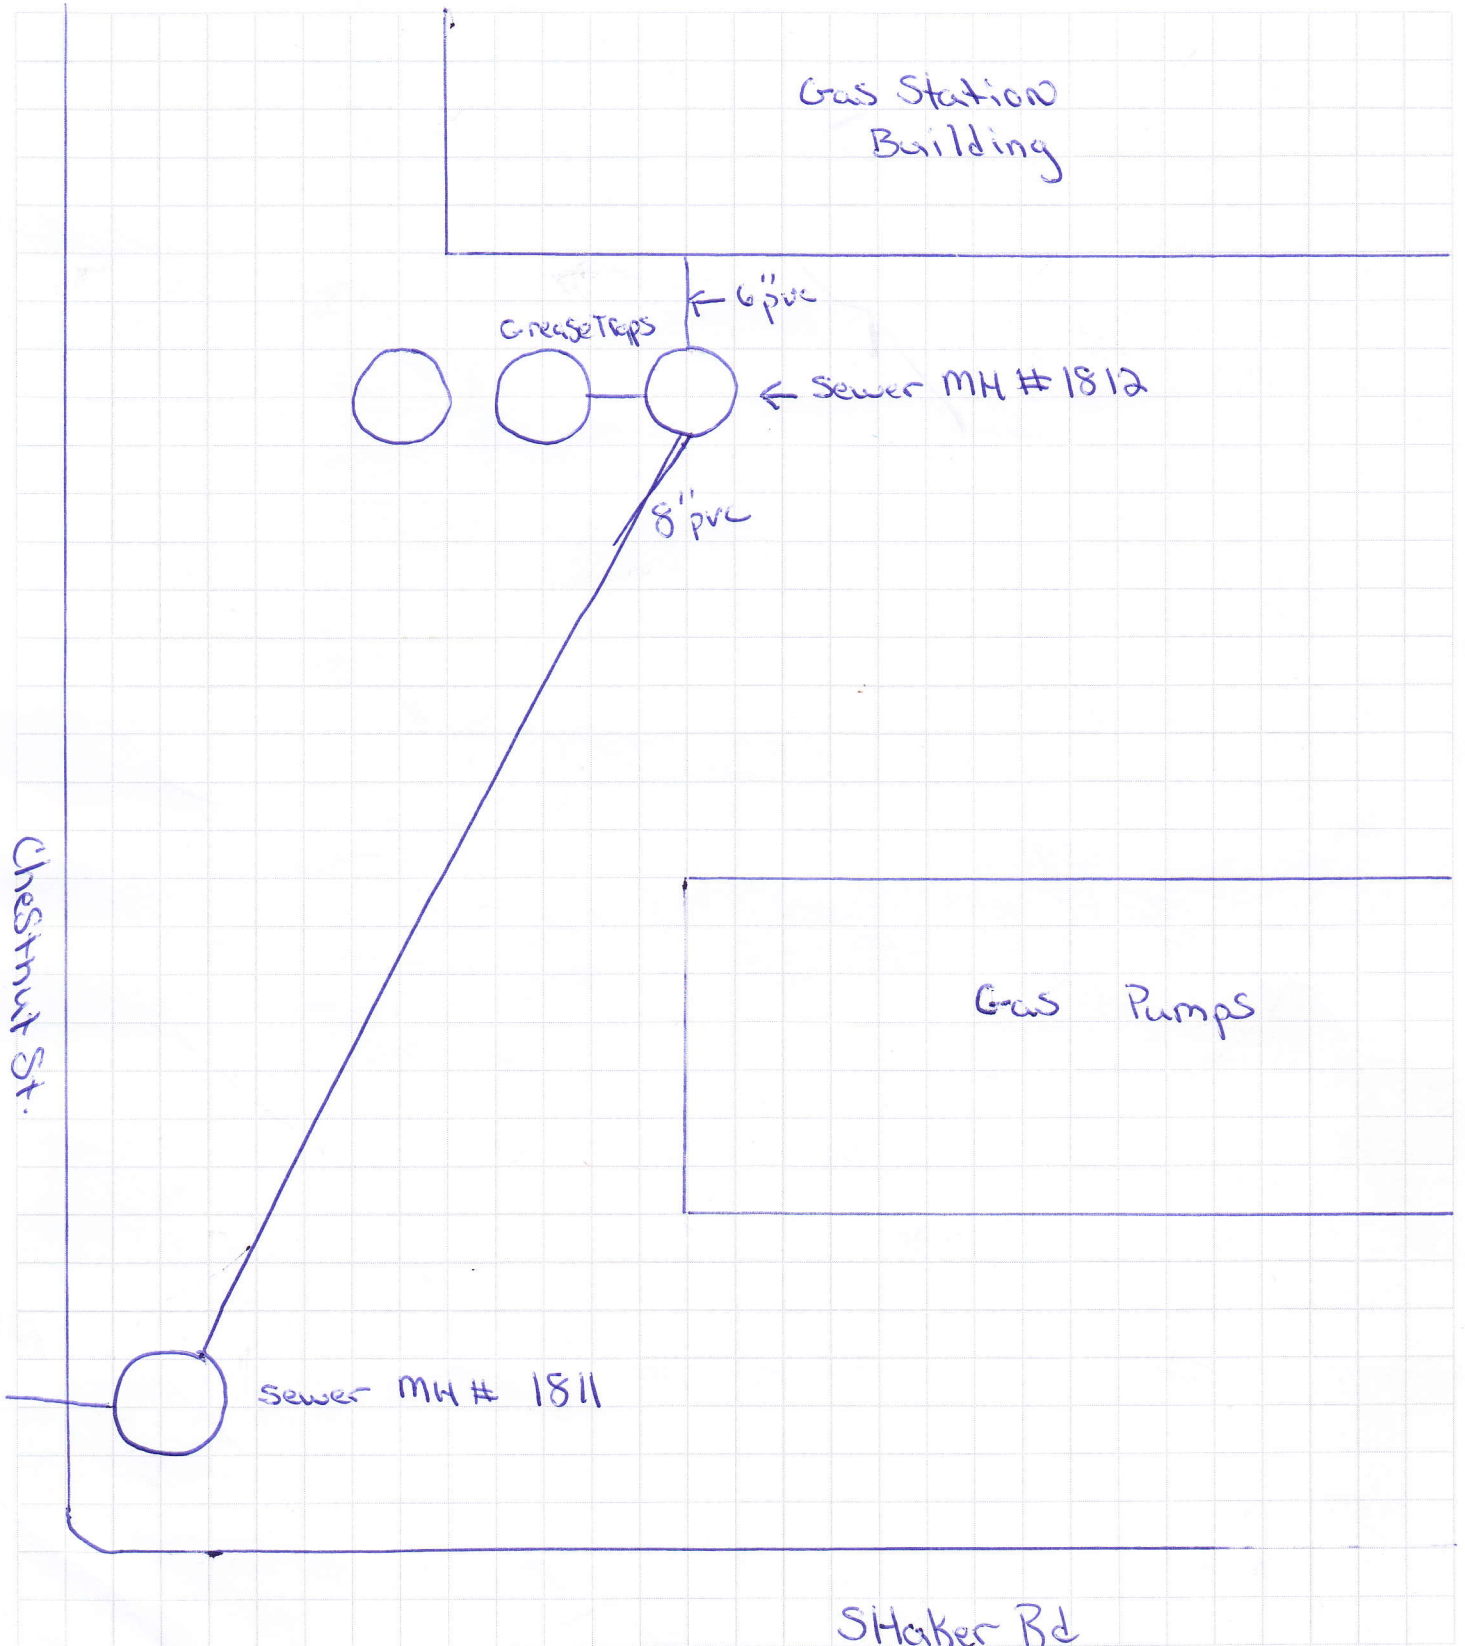

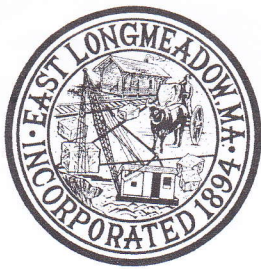

EAST LONGMEADOW DEPARTMENT OF PUBLIC WORKS

Job: 227 Shaker Rd # Chestnut (Sewer)

Sheet No: (Sewer MH # 1811) of _____

Calculated By: Josh C. Date 2-8-2017

Scale: _____

