

No. Street

(San. Sewer)


Lot No.

518

SHAKER ROAD

Inspected

7-25-12

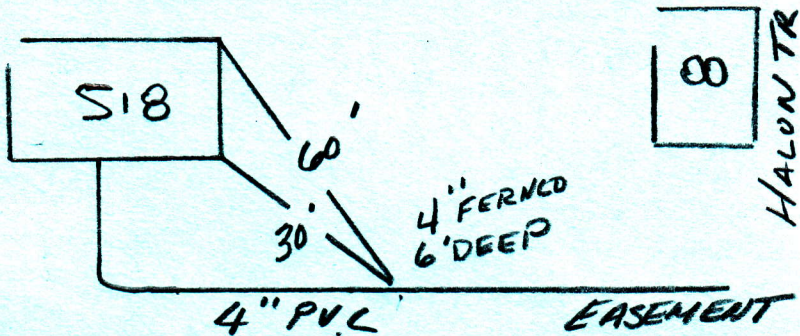

SHAKER ROAD