



No. Street Lot #2 (San Sewer) Lot No.
9 SKYLINE DR. Inspected

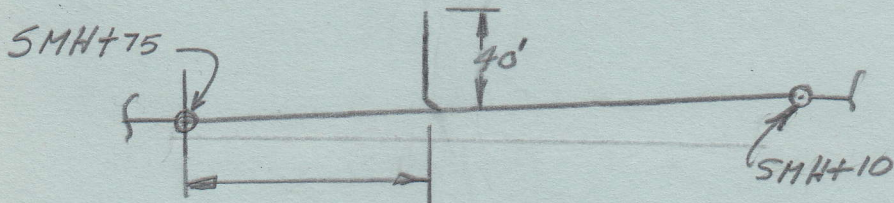

No. Street Lot #3 (San Sewer) Lot No.
19 SKYLINE DRIVE Inspected

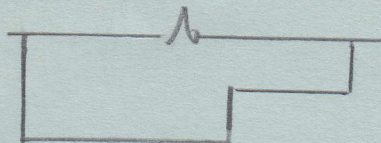