
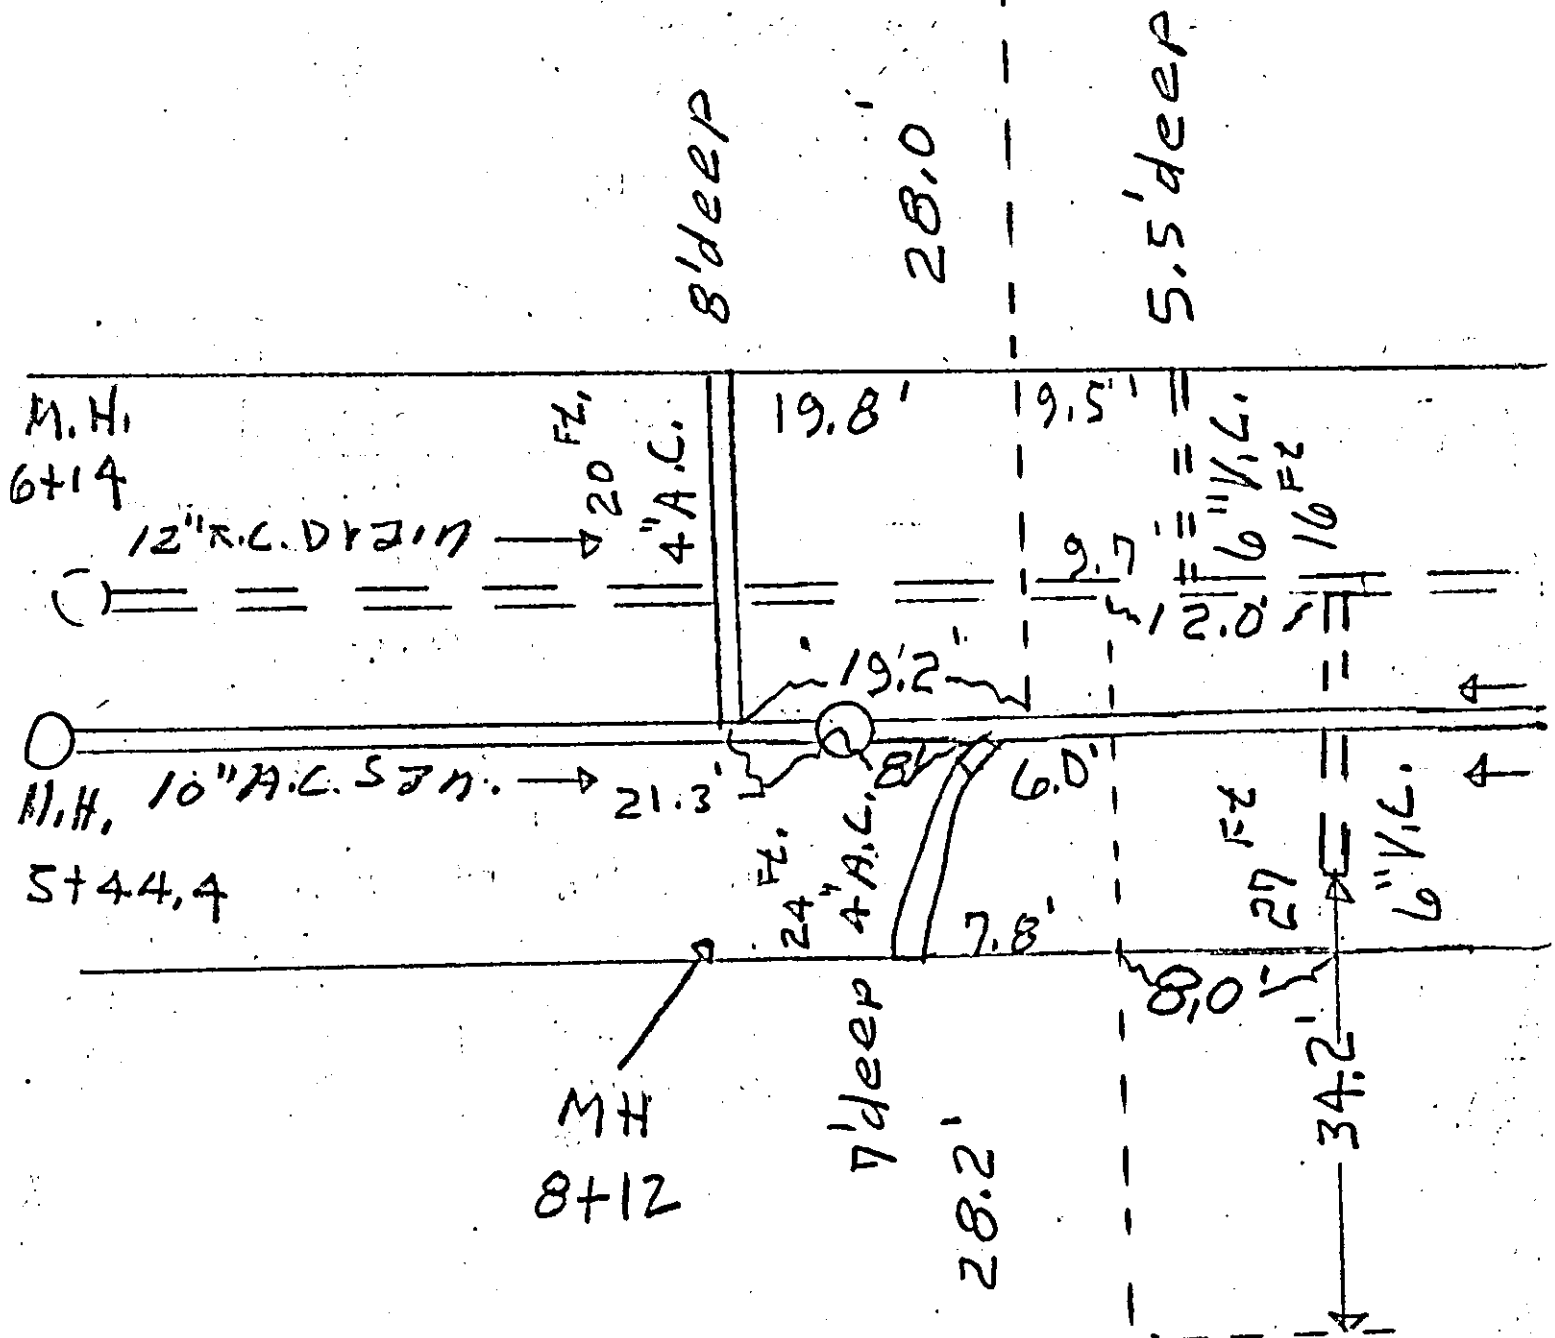


70 Slumber Lane
AUG. 1965

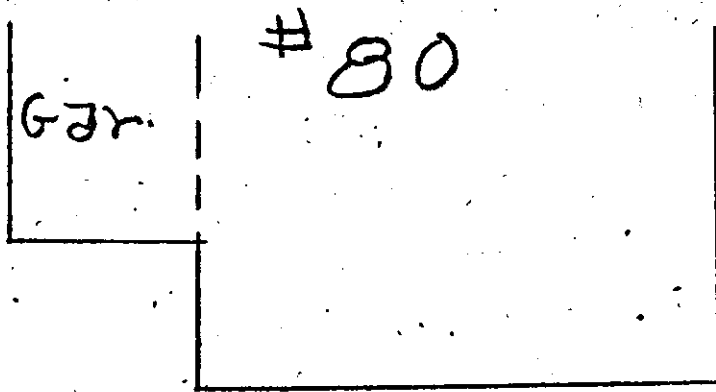

M.H.
8+12

#77
4" - y & 22 1/2° Bend

SD 25538

25536