


2-8-71 #117 SLUMBER LANE 119

6' DEEP CONNECTED

← 27398

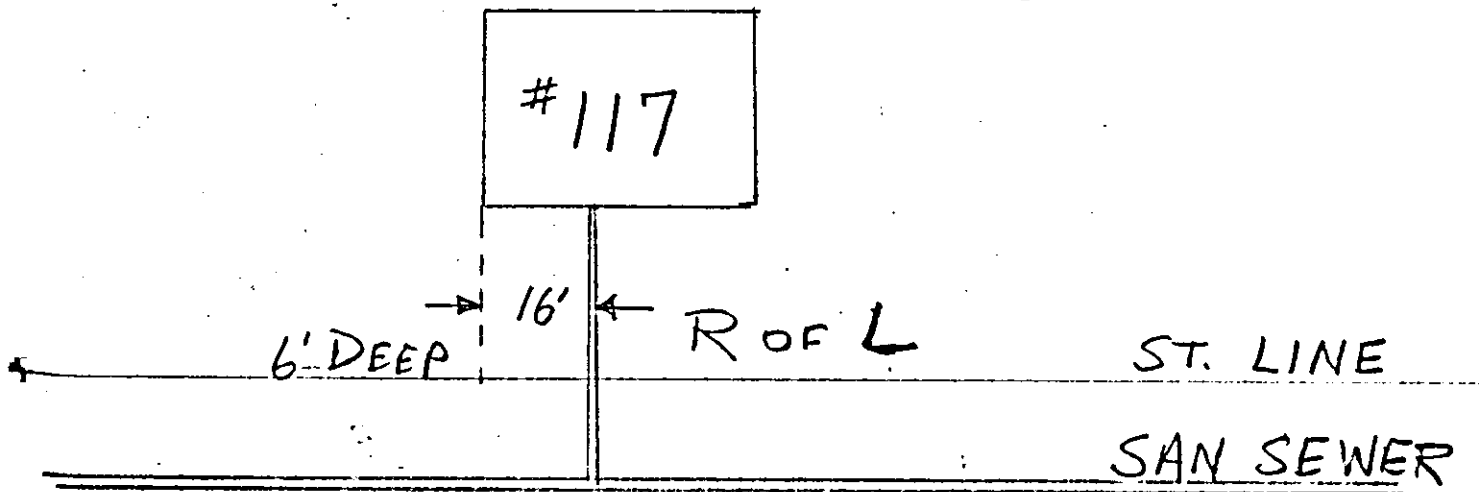

SLUMBER LANE