


2-15-71

124 SLUMBER LANE

6' DEEP - CONNECTED

27398 →

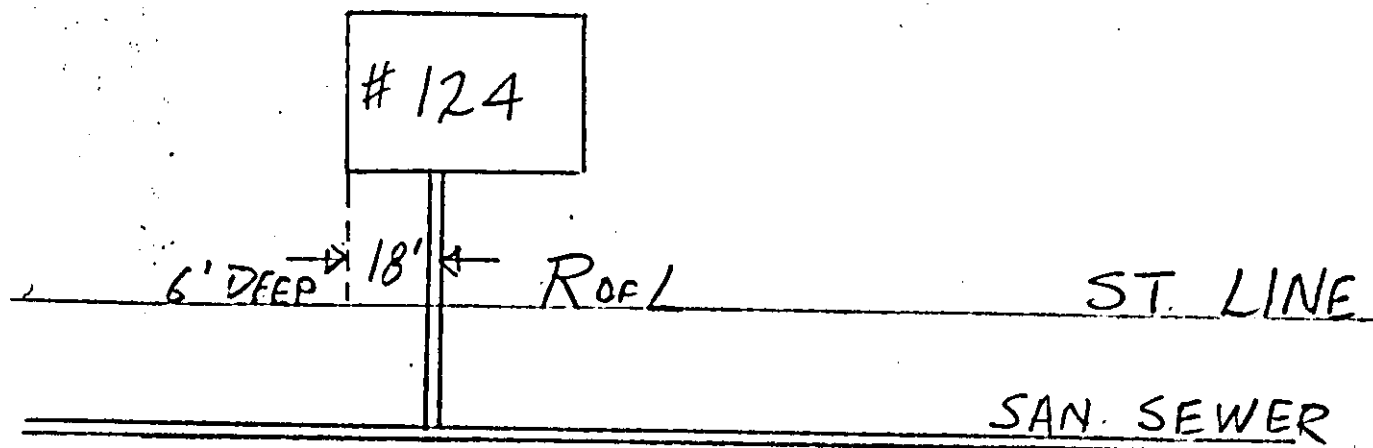

SLUMBER LANE