


76 Slumber Lane
Aug. 1965

77

25535


SD 25537

Celia St.

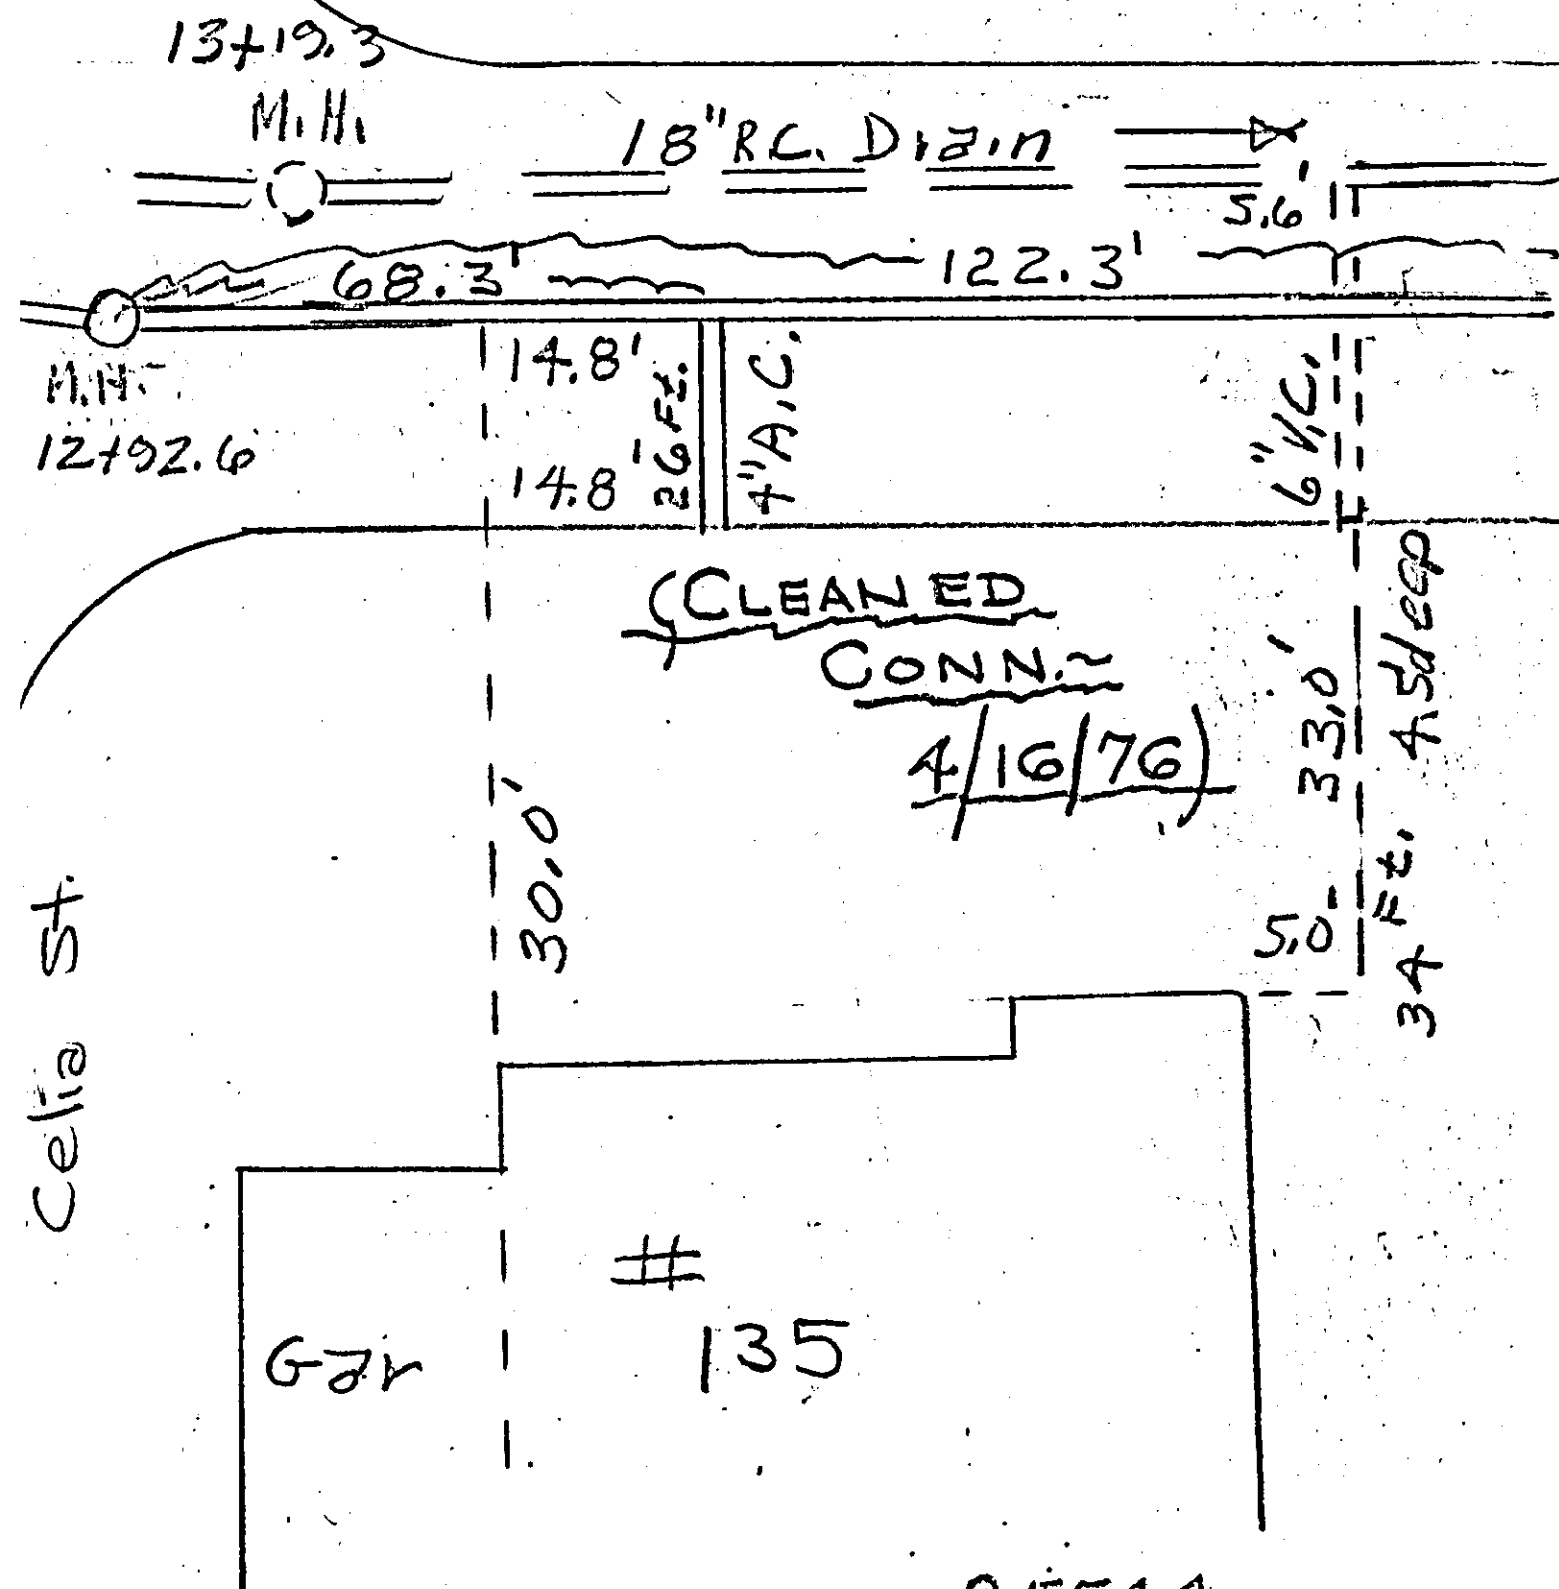

SD 25544
SD 25545

#140

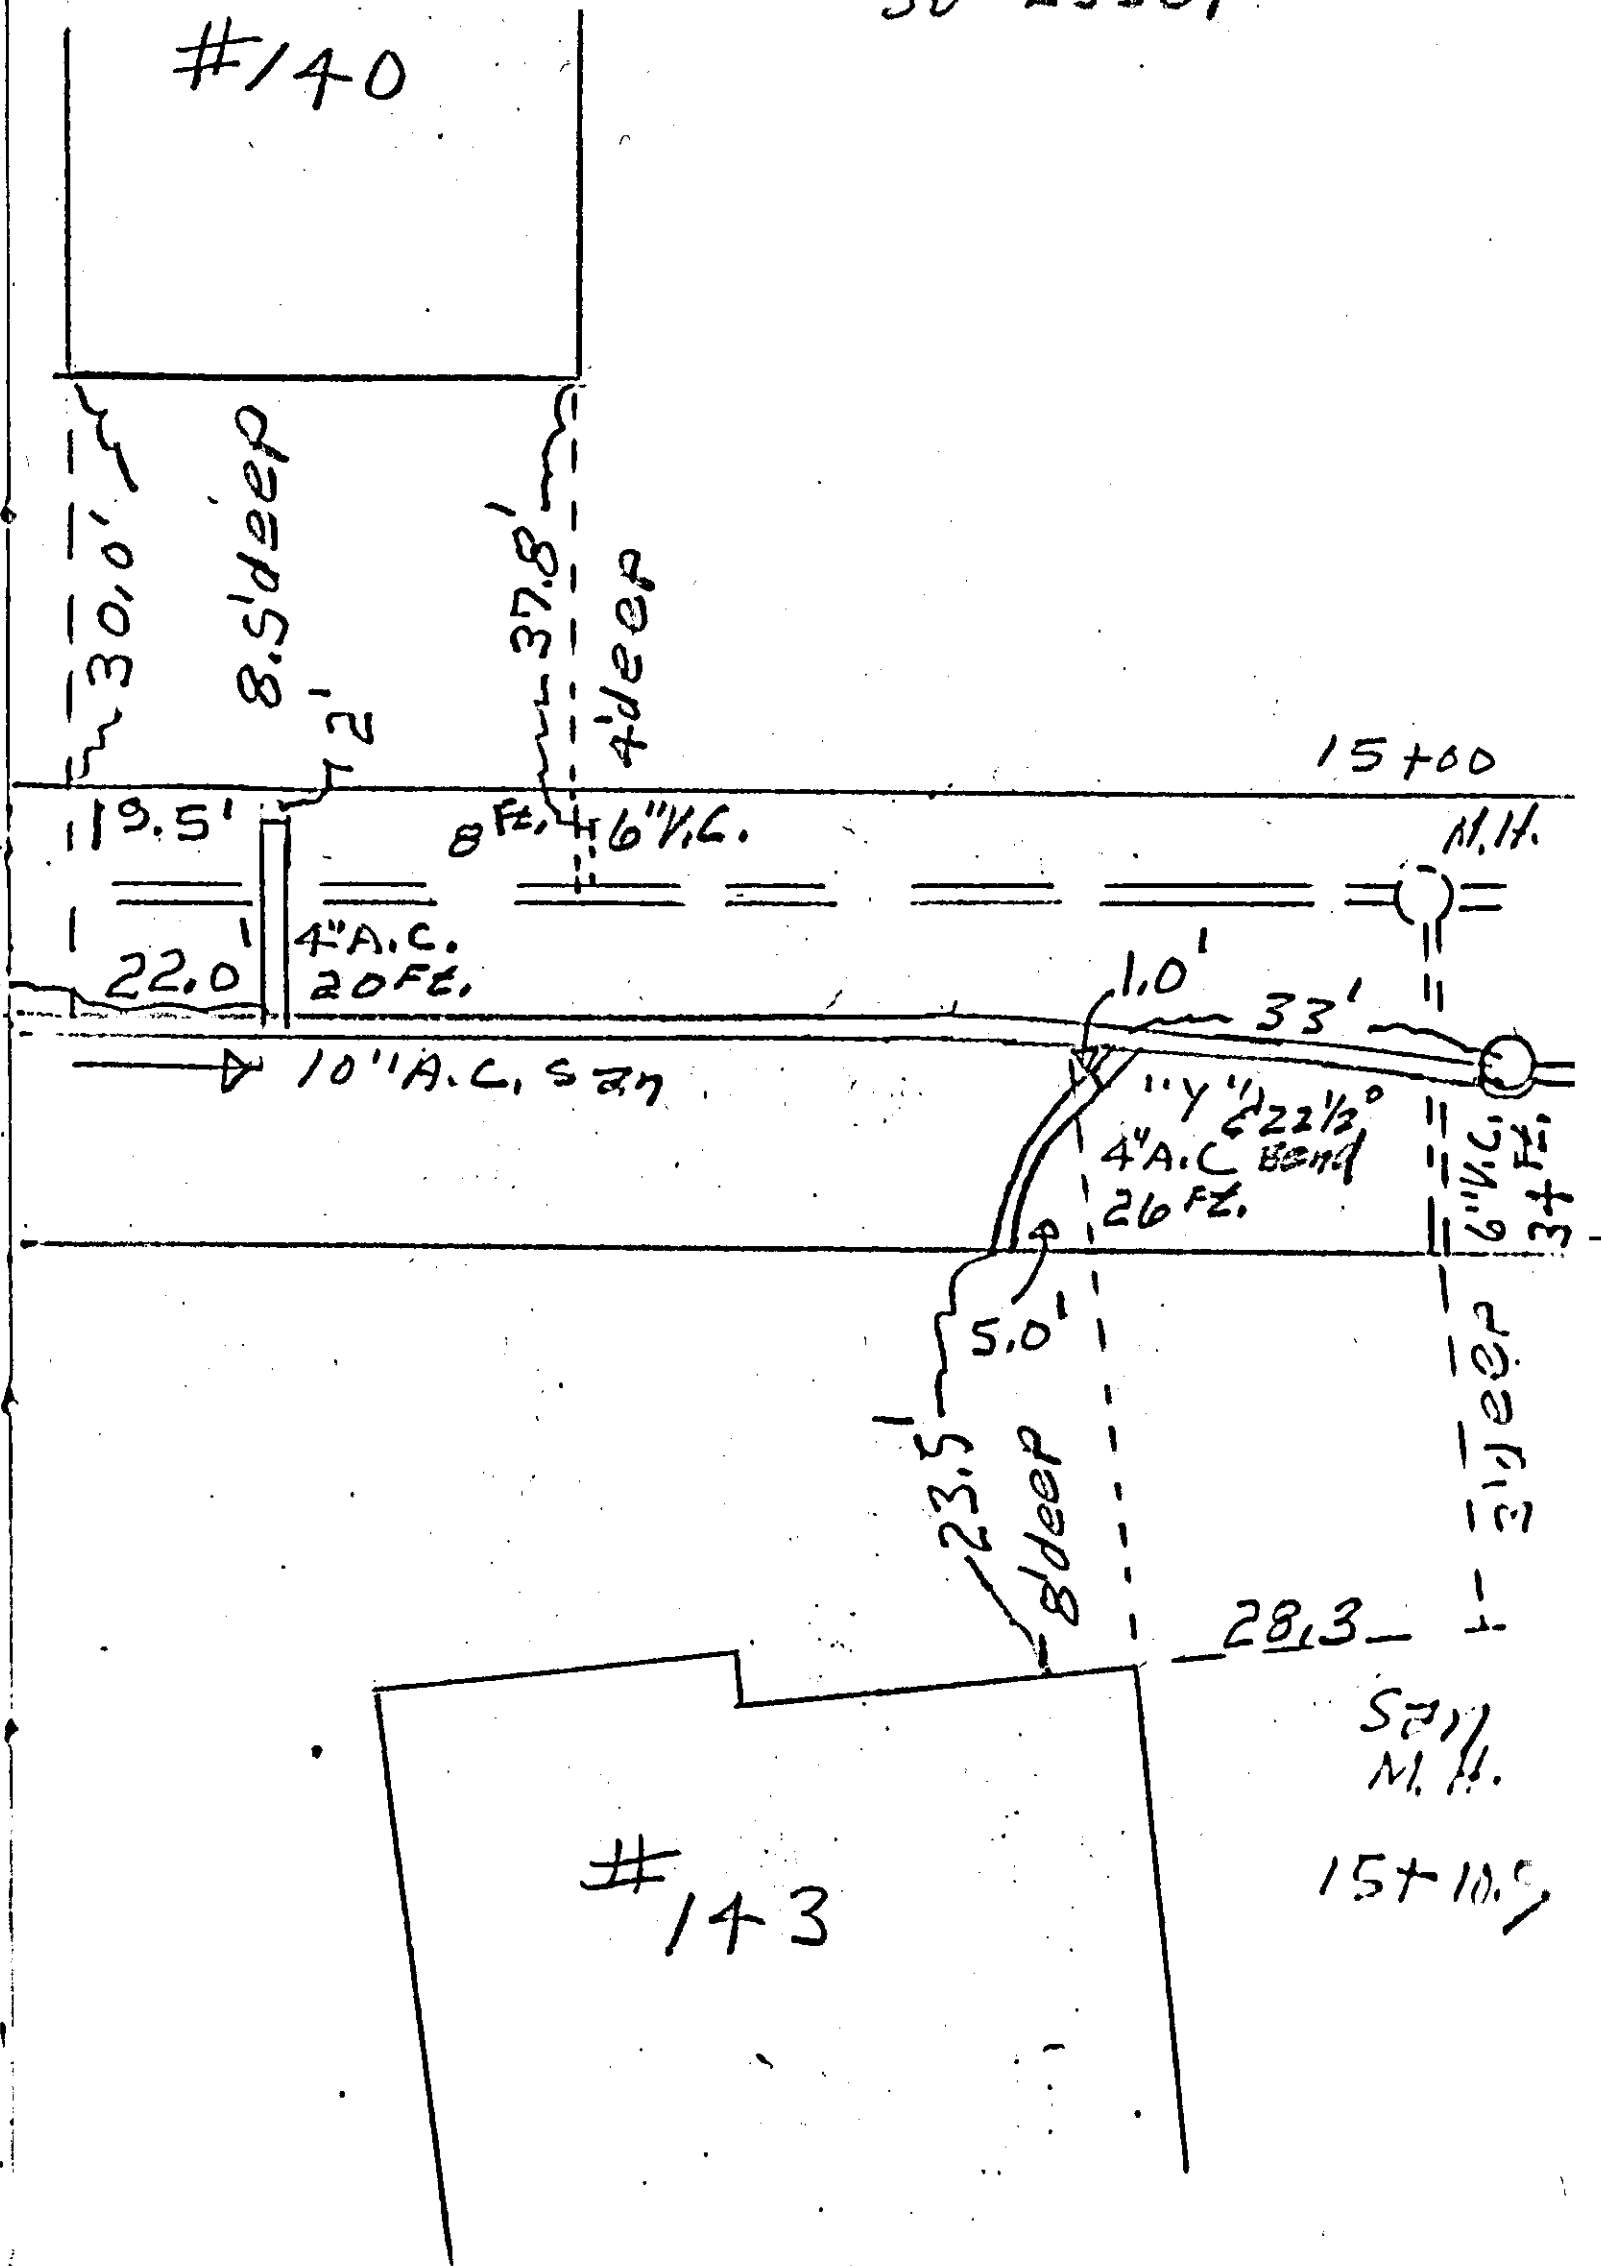

SD 25533
SD 25540