
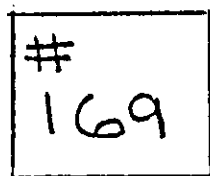


9-24-70 # 169 SLUMBER LANE

5' DEEP - CONNECTED

27317

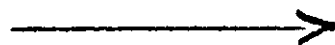

5' DEEP | 2' | L. OF R.

\$

SAN. SEWER

SLUMBER LANE