




EAST LONGMEADOW DEPARTMENT OF PUBLIC WORKS

Job: 26 Smith (Sewer) and Stub for Vacant lot

Sheet No: Excavator - OSS - Mark Kline of

Calculated By: Pope Date 6-23-2022

Scale: _____

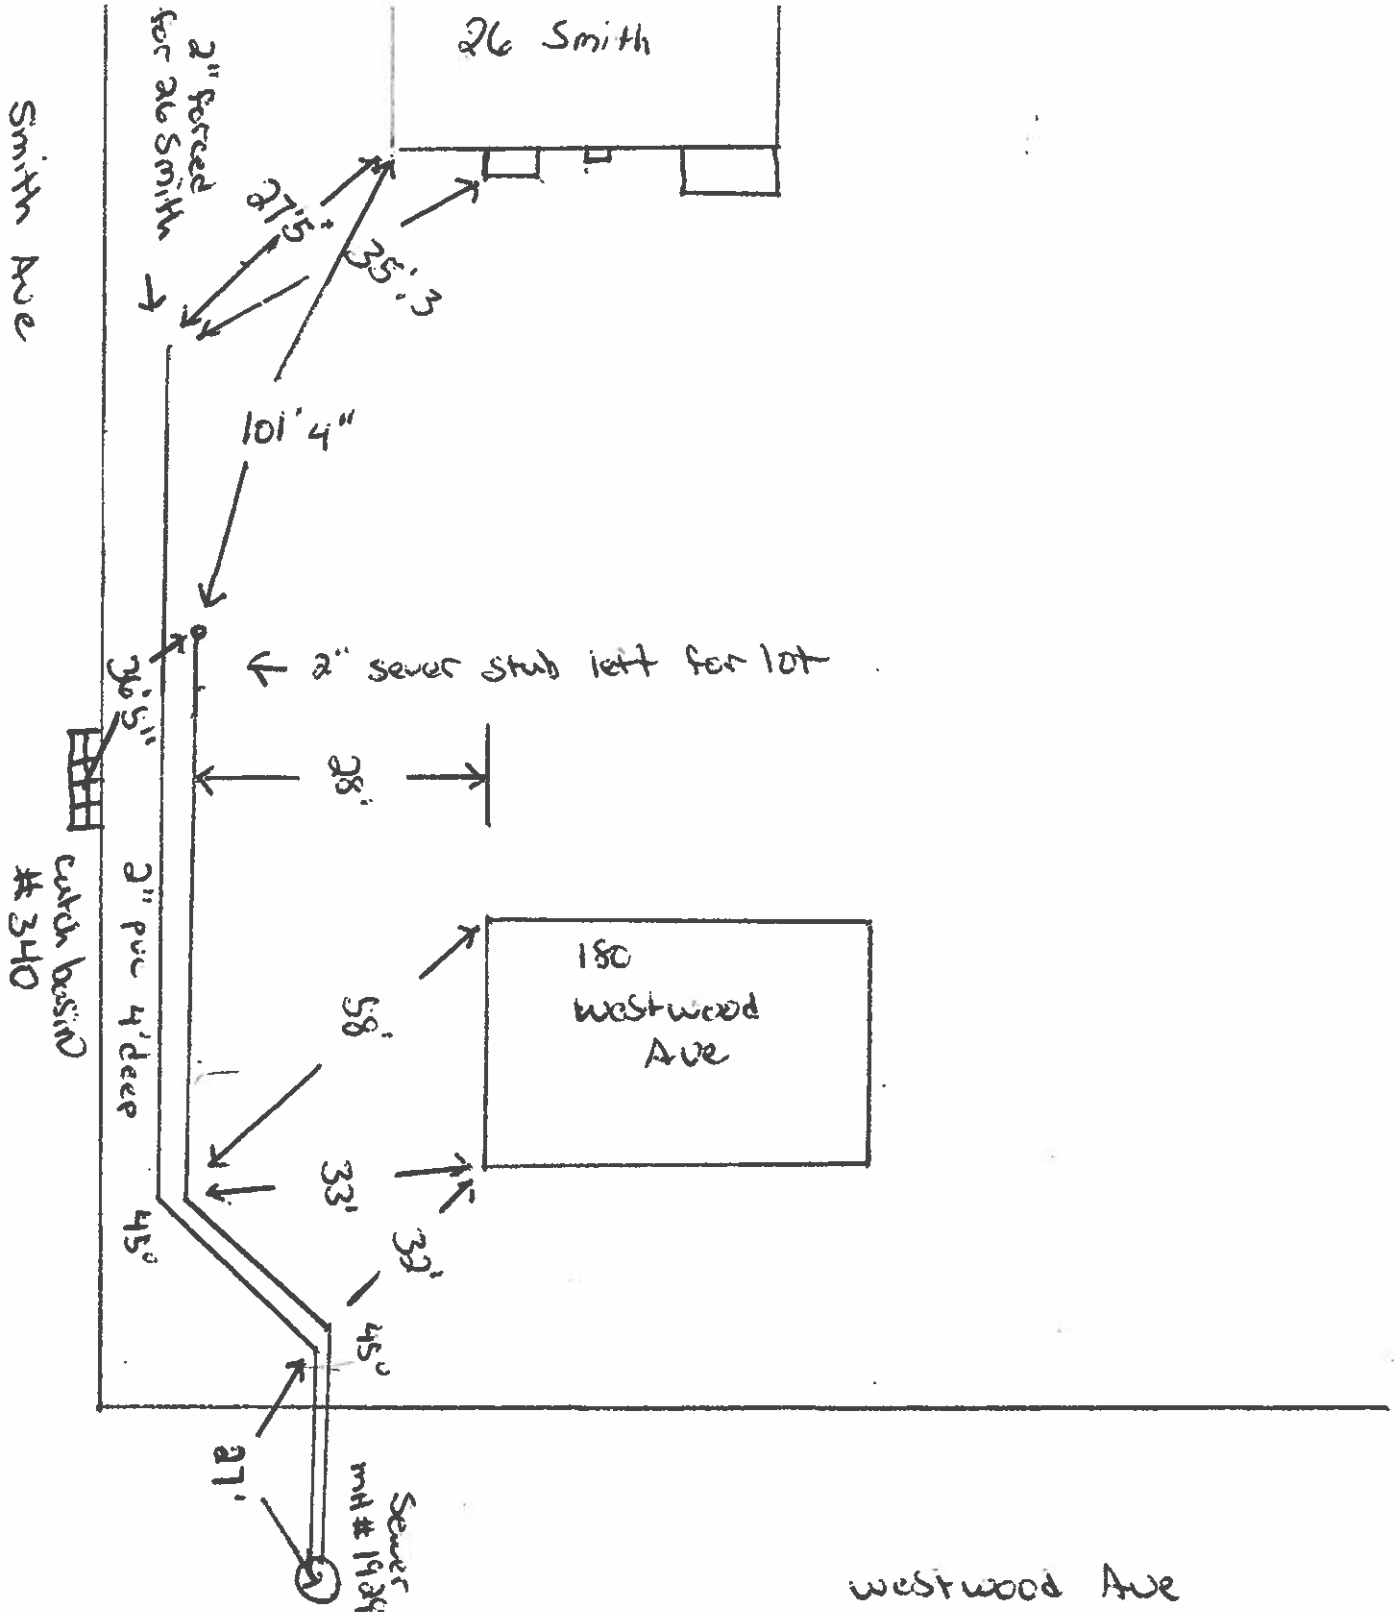

westwood Ave