




EAST LONGMEADOW DEPARTMENT OF PUBLIC WORKS

Job: 65 Smith Ave - Sewer

Sheet No: Job Done By Excavation Plus

Calculated By: Pope Ruel Date 10-26-15

Scale: _____

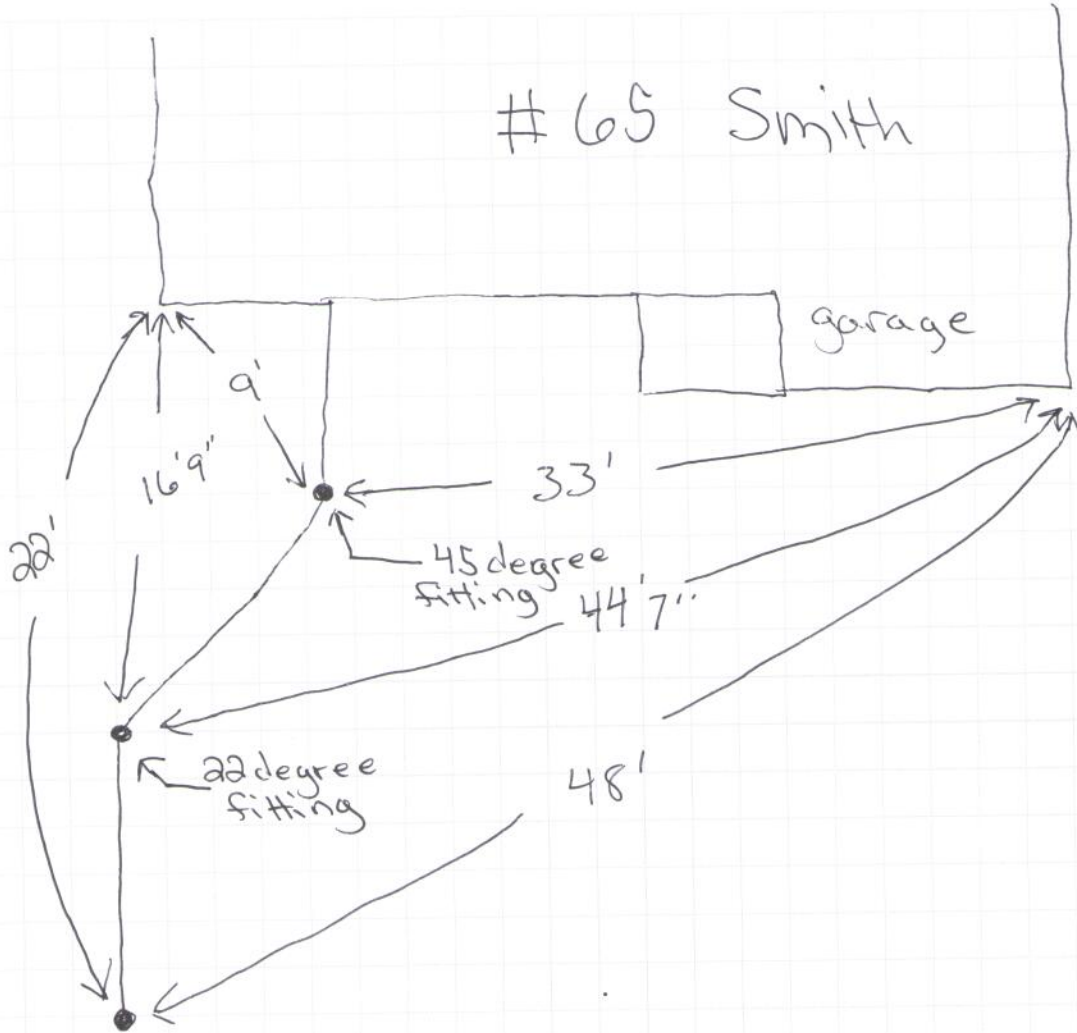

4" pvc pipe
4' 7" deep