




EAST LONGMEADOW DEPARTMENT OF PUBLIC WORKS

Job: 248 Somers Rd. (Sewer)

Sheet No: _____ of _____

Calculated By: Pope Date: 5-9-18

Scale: _____

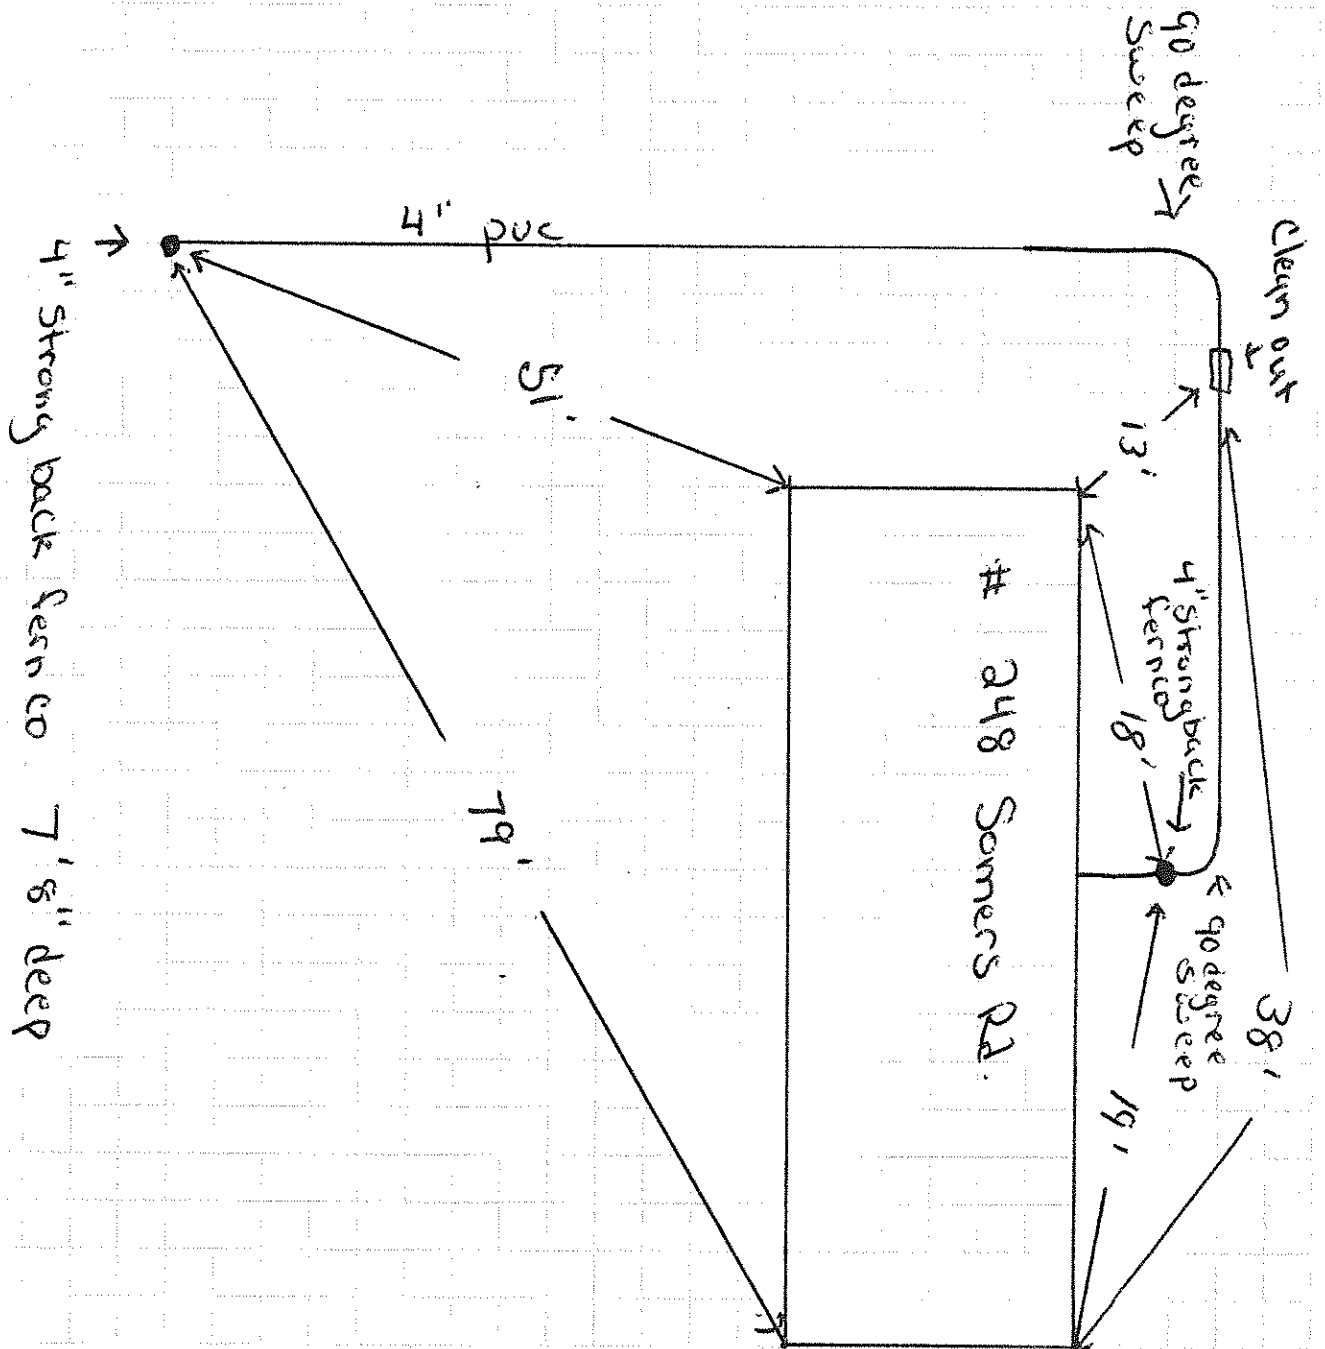

Somers Rd.