




EAST LONGMEADOW DEPARTMENT OF PUBLIC WORKS

Job: 37 South Bend (Sewer)
Sheet No: Excavator - Excavation Plus of _____
Calculated By: Pope Date 5-9-2022
Scale: _____

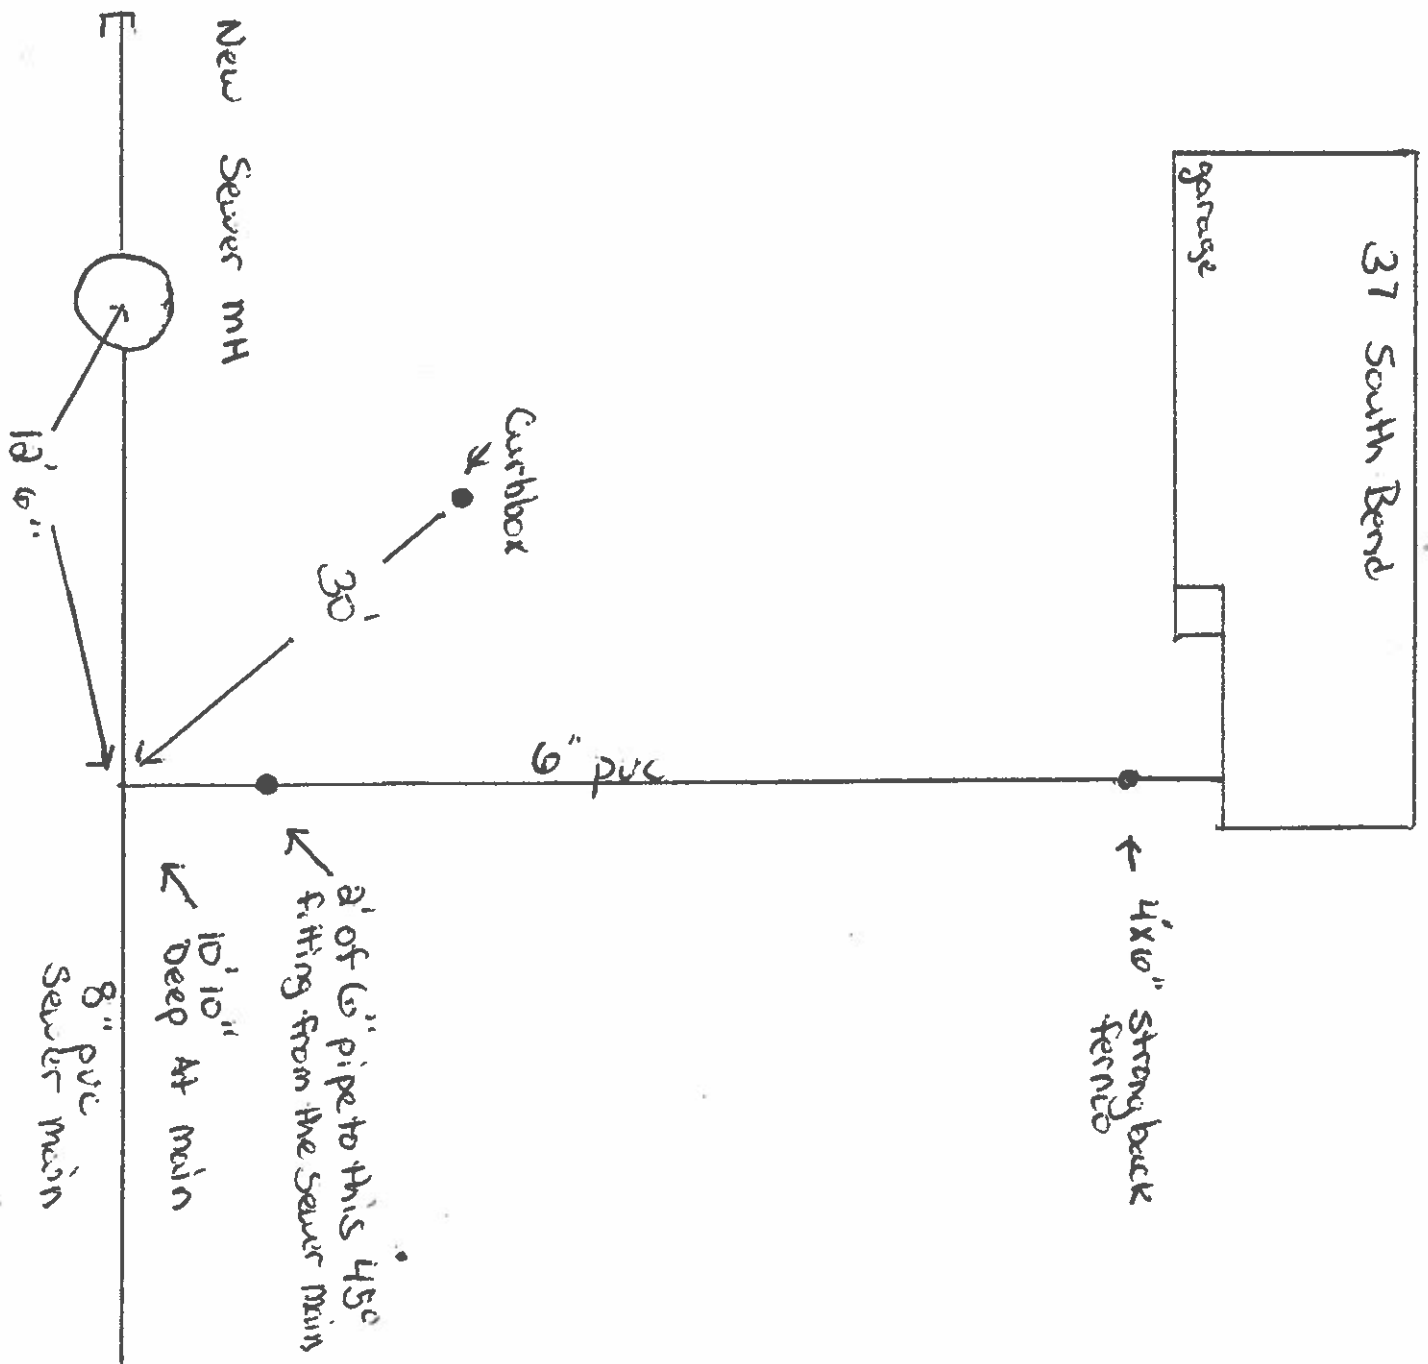

**TOWN OF EAST LONGMEADOW, MA
DEPARTMENT OF PUBLIC WORKS
SEWER INSPECTION**

DATE: 5-9-2022

Sanitary

Storm

Other

Size 6" pvc

Fee \$50.00

Inspected Yes

LOCATION OF PROPERTY: 37 South bend

OWNER:

Is drain under cellar floor

Feet above cellar floor

If building has cellar or footing drains, where do they discharge:

The above fee is for the initial inspection. If initial inspection is not approved, there will be an additional fee of \$25.00 for each inspection.

It is understood that only sanitary waste is to be connected to the sanitary sewer and only clean surface or sub-surface water to storm drain.

Thomas H. Pye

DPW Inspector