




EAST LONGMEADOW DEPARTMENT OF PUBLIC WORKS

Job: 40, 40A, & 40 B Spruce St.
Sheet No: Sewer connections of Rd 600
Calculated By: _____ Date 8-14-15

Scale:

40 B

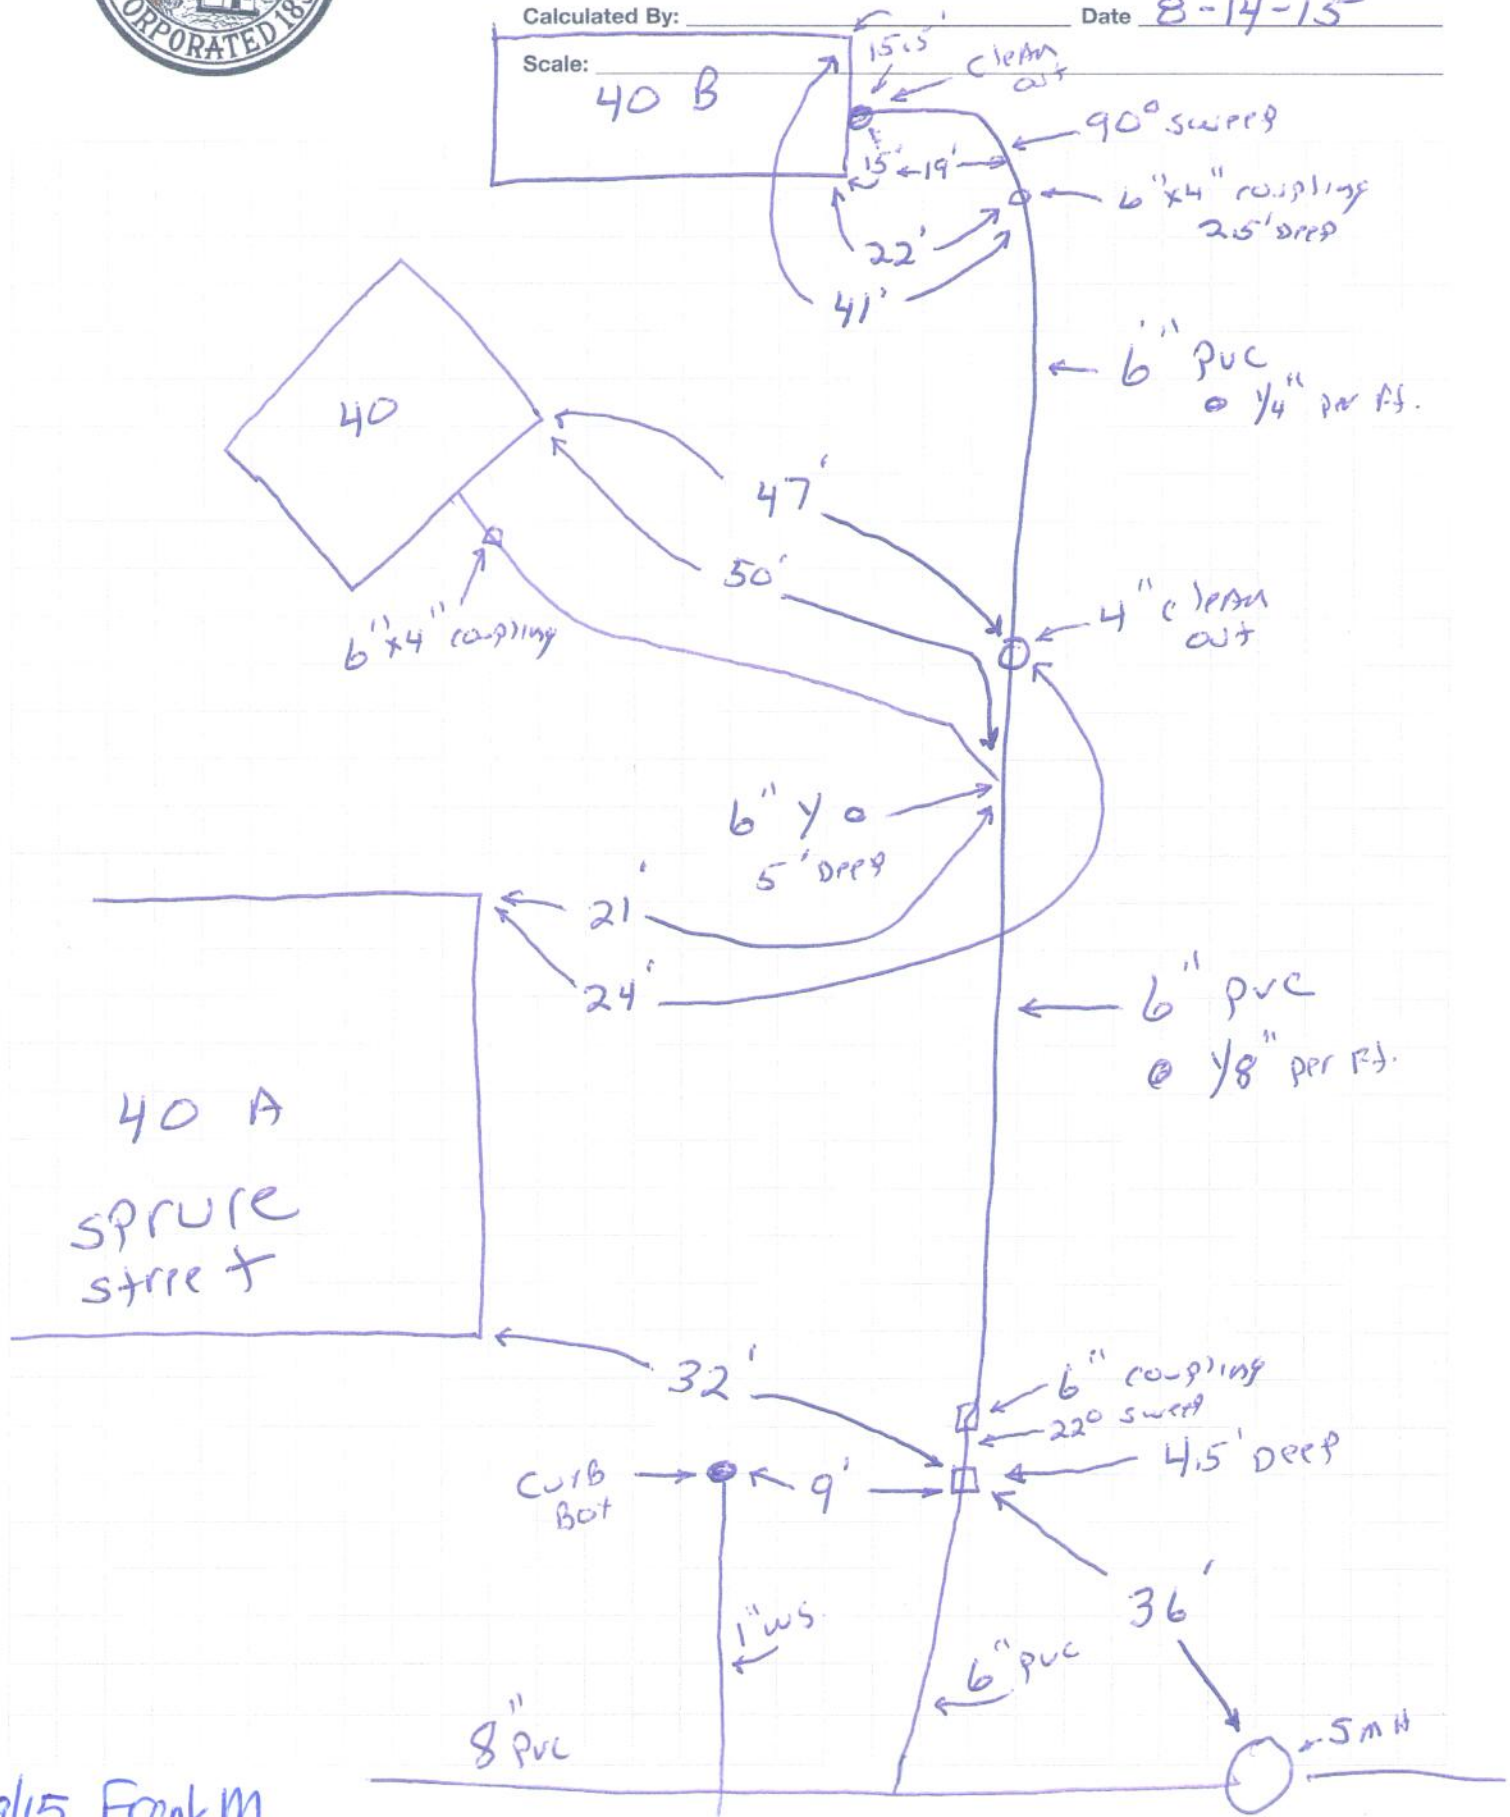

8/19/15 Frank M.



EAST LONGMEADOW DEPARTMENT OF PUBLIC WORKS

Job: 40 Spruce #40 B

Sheet No: _____ of _____

Calculated By: Pope, Ruel Date 8-14-15

Scale: _____

