



Job: Vacant lot South of 180 Westwood (Sewer)

Sheet No:


of

Calculated By:

Rope

Date: _____

Scale:

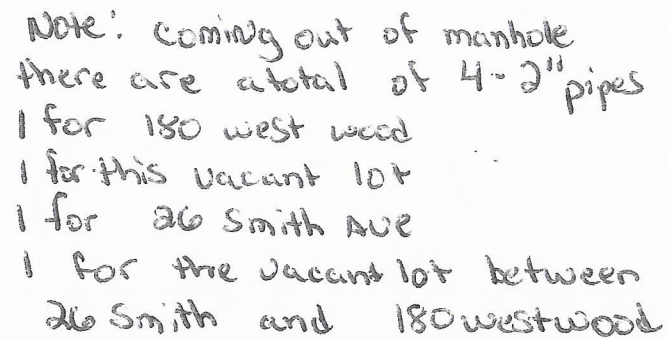

6/23/22 Scanned to GIS