


No. Street (San. Sewer) Lot No.
6 WISTERIA LANE Inspected 10-4-13

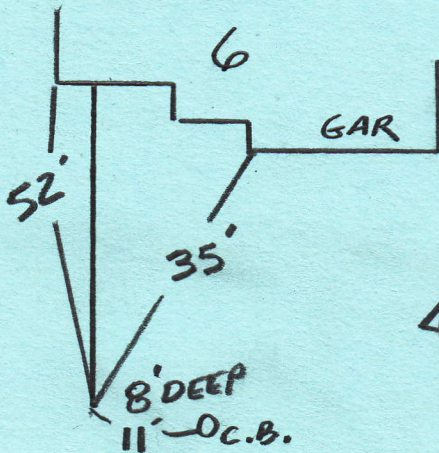

4" PVC