
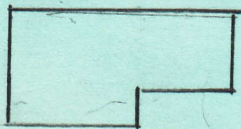


No. Street Lot # 5 (San Sewer)

Lot No.

15 YORKSHIRE PLACE

Inspected

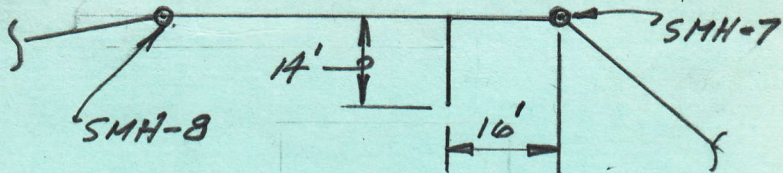

YORKSHIRE PLACE