
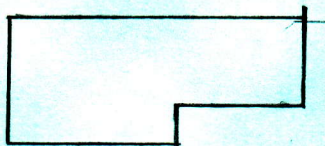


No. Street LOT #6 (San Sewer)

Lot No.

23 YORKSHIRE PLACE

Inspected

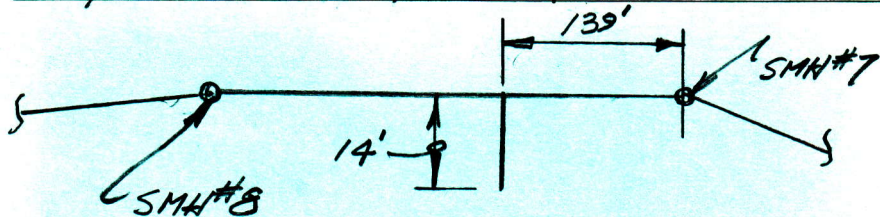

YORKSHIRE PLACE