


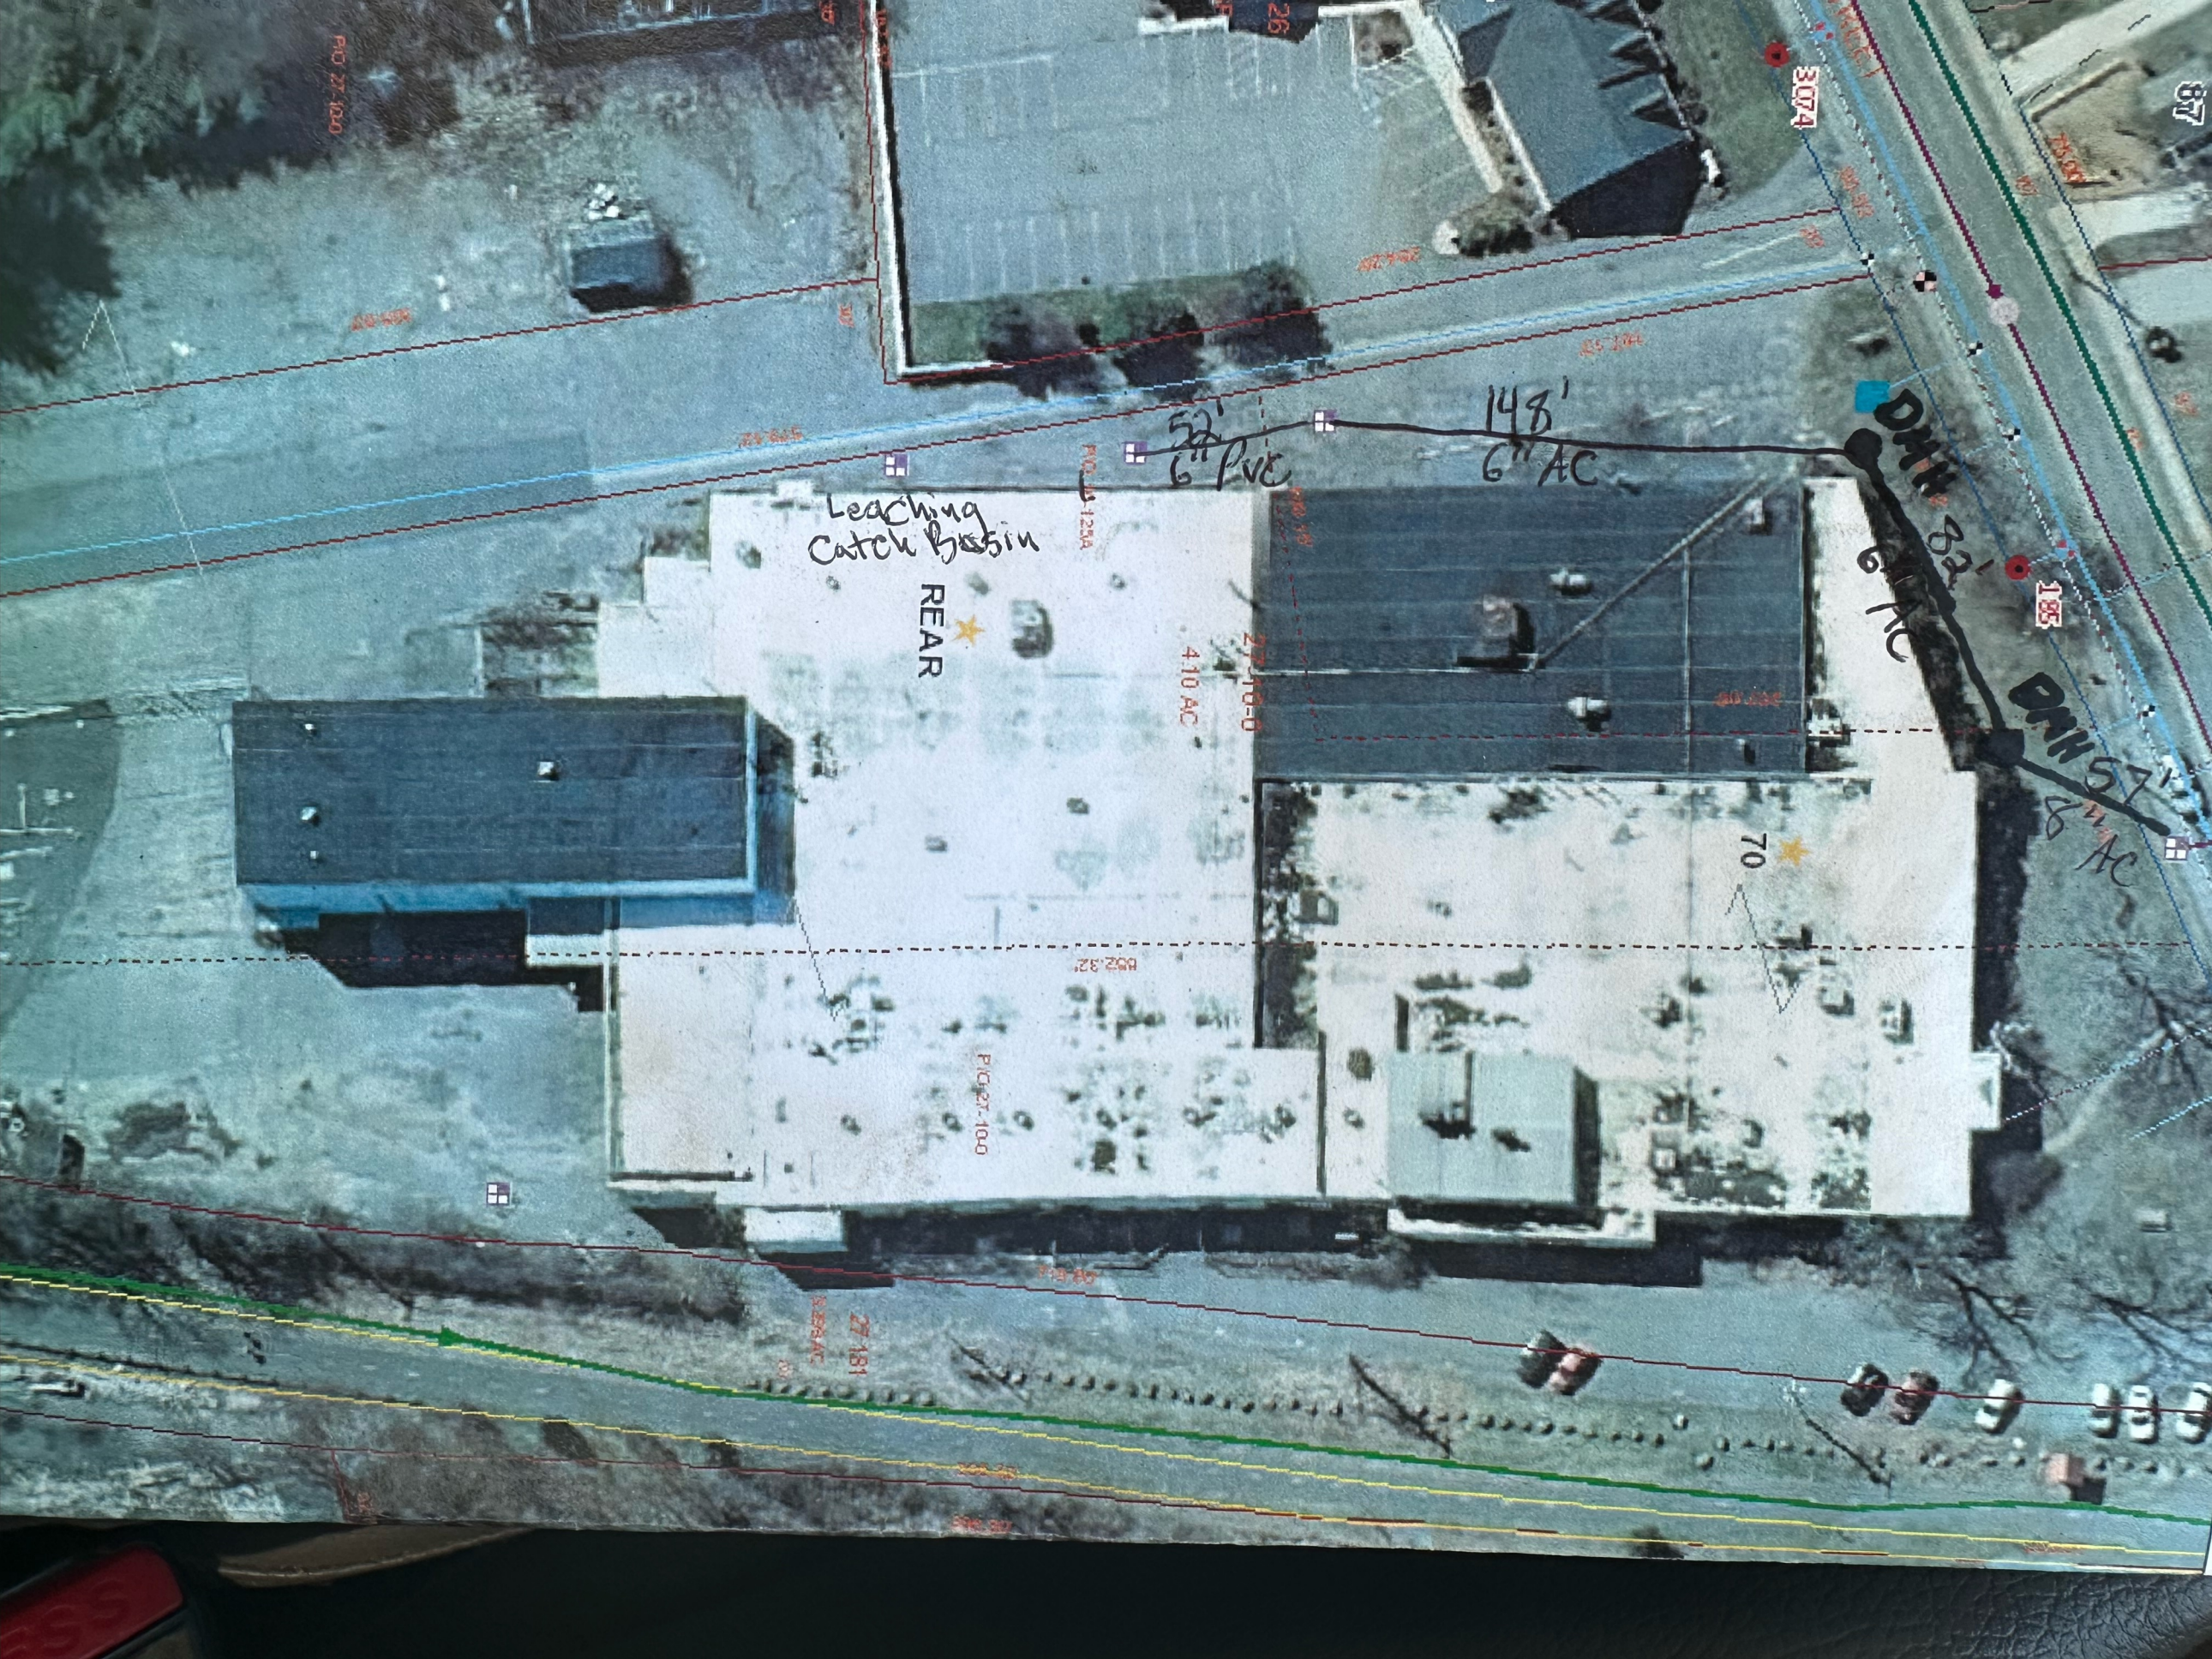

Leaching
Catch Basin
REAR

52'
6" PVC

148'
6" AC

Driv 52'
6" AC

Driv 57'
8" AC

PIC 27.1000

410 AC

27.40-0

70

002.32'

27.181
5.228 AC

3074

185

87

PIC 27.1000