



ID 78

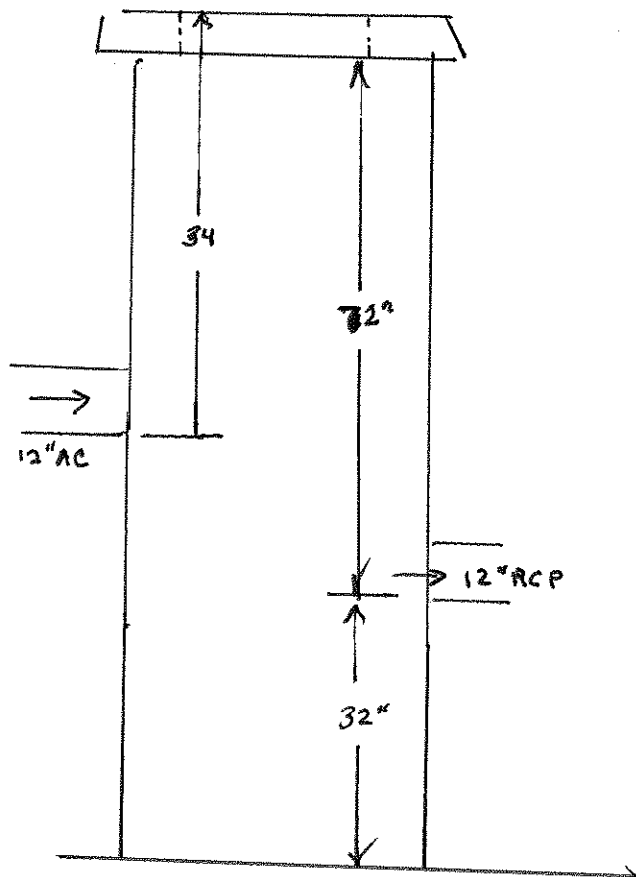

622 N. MAIN ST

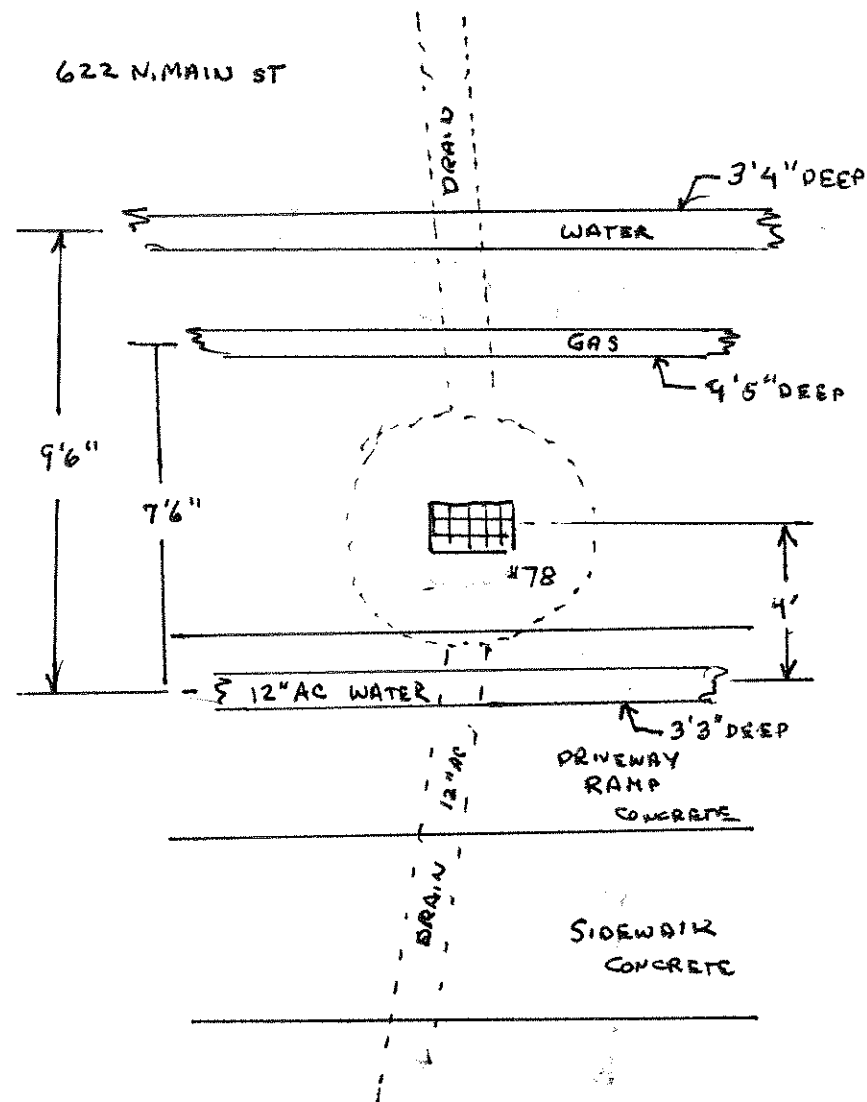

2x2
c8