

NO. STREET


DATE INST.

MAKE:

SIZE

S A Acorn ST.

6-5-13

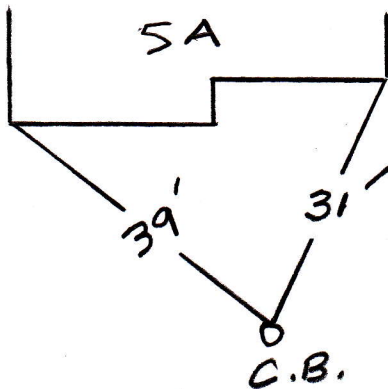

1" COPPER