


NO. STREET

DATE INST.

MAKE:

SIZE

137 ALLEN ST

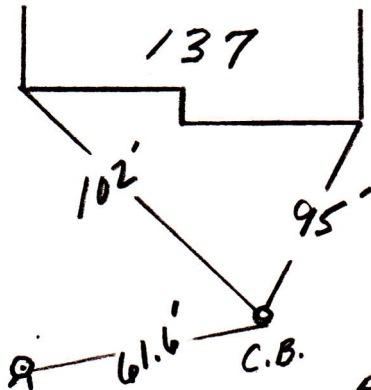

ALLEN ST.